



CITY OF CUPERTINO  
 CITY HALL  
 PARKING LOT and SIDEWALK  
 AREA PLAN

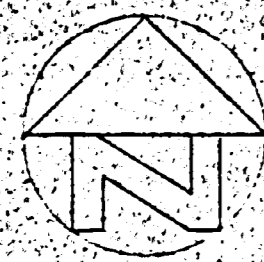

RETURN TO  
CITY OF CUPERTINO  
BUILDING INSPECTION  
DEPARTMENT

RODRIGUES AVENUE

TORRE AVENUE

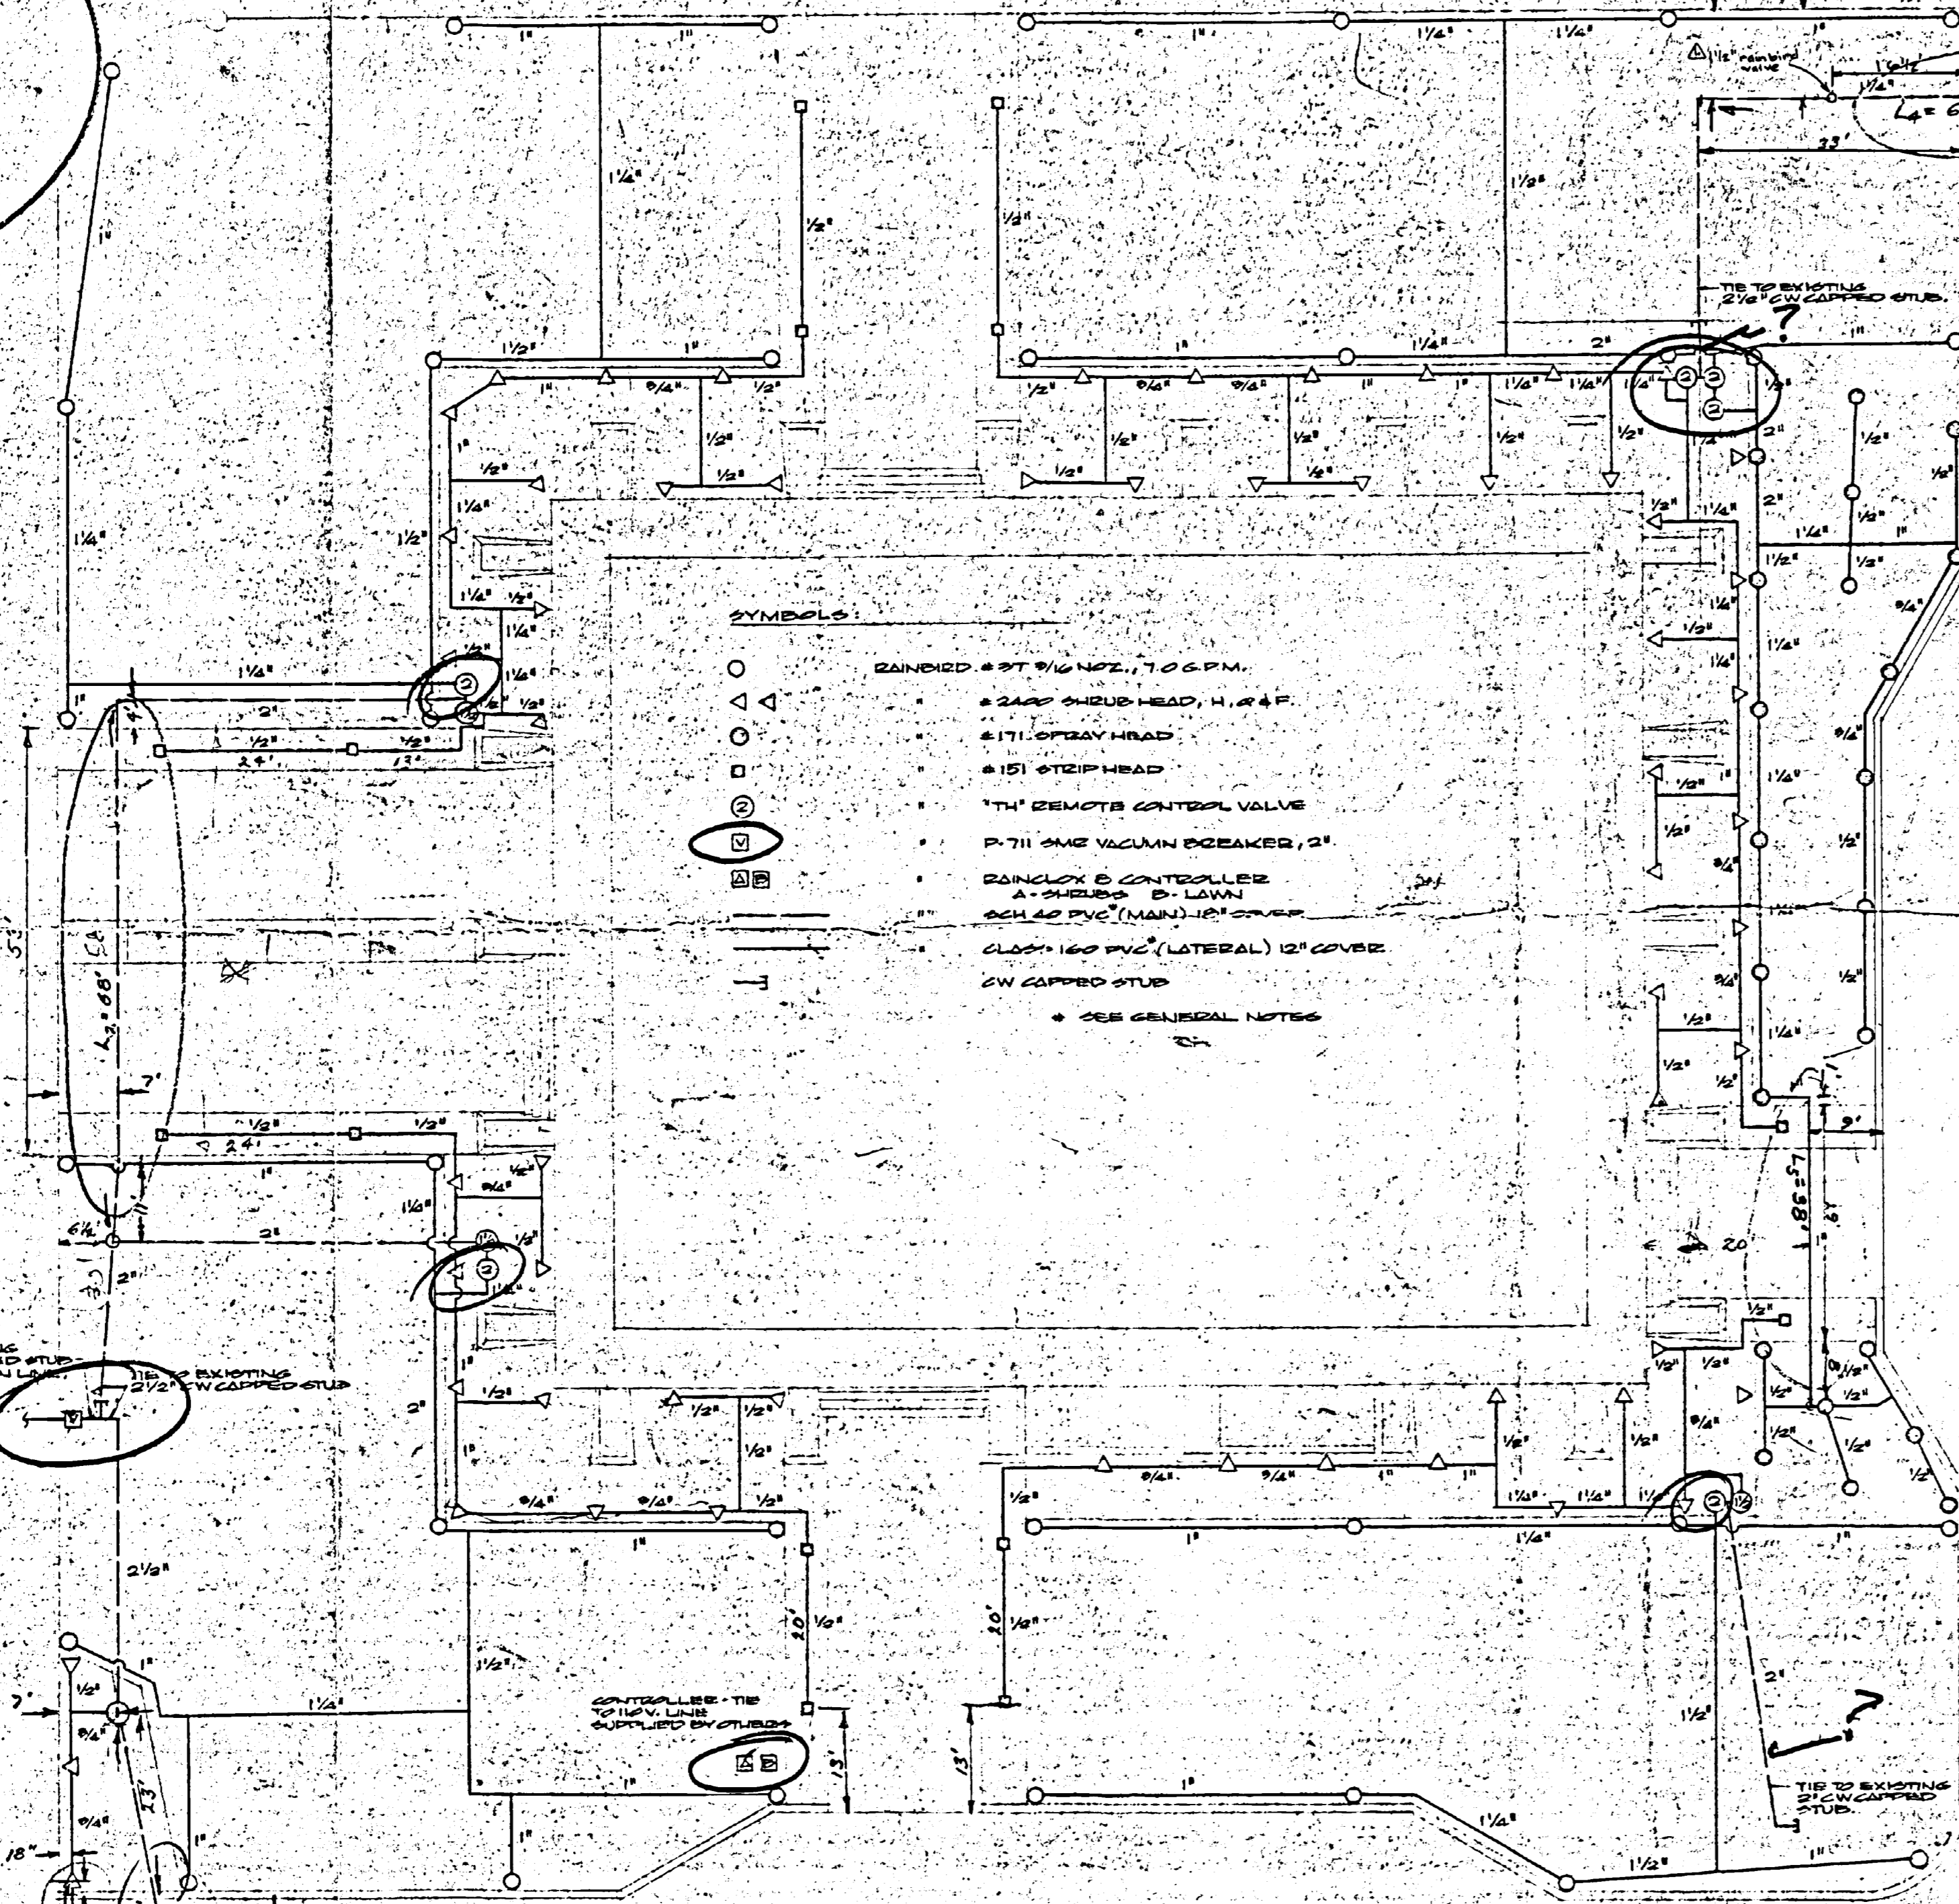


- SYMBOLS:**
- RAINBIRD # 37 9/16 NOZ. 1.70 G.P.M.
  - △ 24" SHRUB HEAD, 4" A.F.
  - ◇ 17" STEEP HEAD
  - 15" STEEP HEAD
  - ⊕ 1" REMOTE CONTROL VALVE
  - ⊖ 2" 7/8" S.W. VALVE BREAKER, 2"
  - ⊗ RAINBIRD 6 CONTROLLER
  - ⊙ A - SHRUBS B - LAWN
  - ⊛ SCH 40 PVC (MAIN) 12" COVER
  - ⊞ 1/2" 160 PVC (LATERAL) 12" COVER
  - ⊟ 2" W. CAPPED STUD
  - ⊠ SEE GENERAL NOTES


TIE TO EXISTING 2" W. CAPPED STUD & PLACE SHOWN IN LATER RECONNECT.

CONTROLLER - THE SUPPLY LINE SUPPLIED BY OTHERS


TIE TO EXISTING 2" W. CAPPED STUD

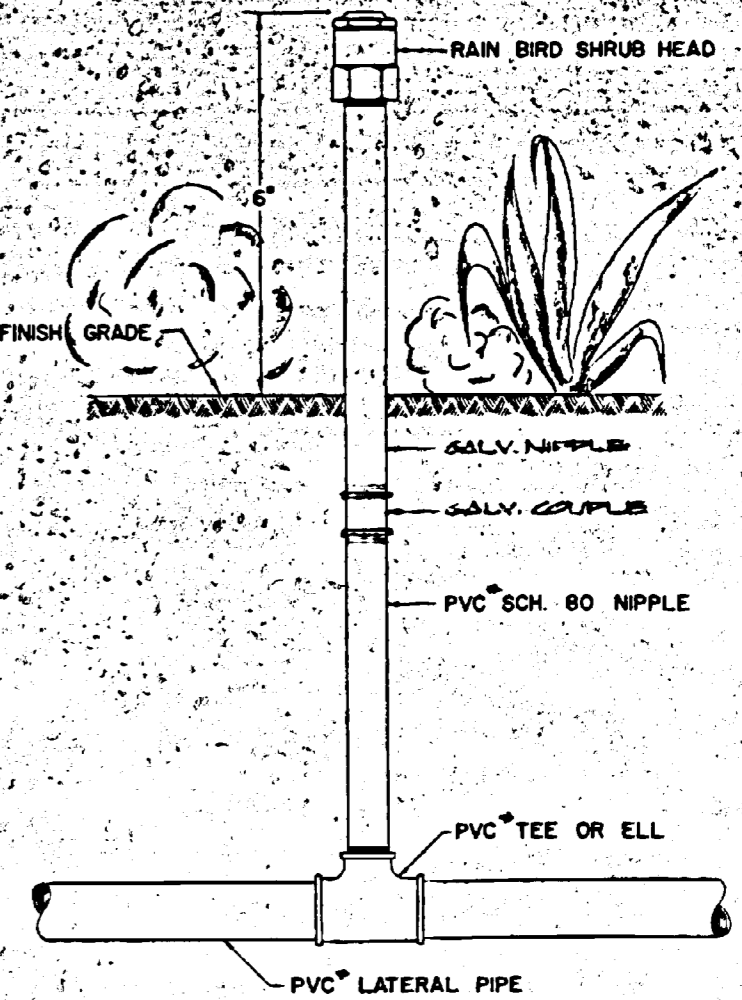


TYPICAL SHRUB HEAD DETAIL

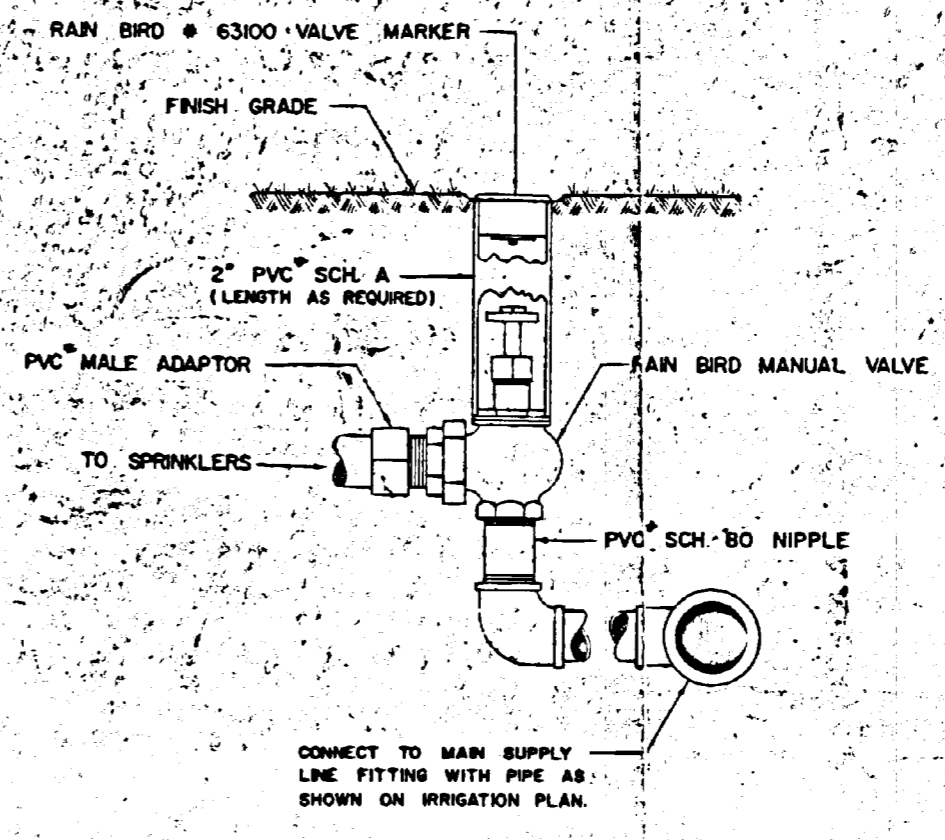

TYPICAL MANUAL VALVE ASSEMBLY DETAIL

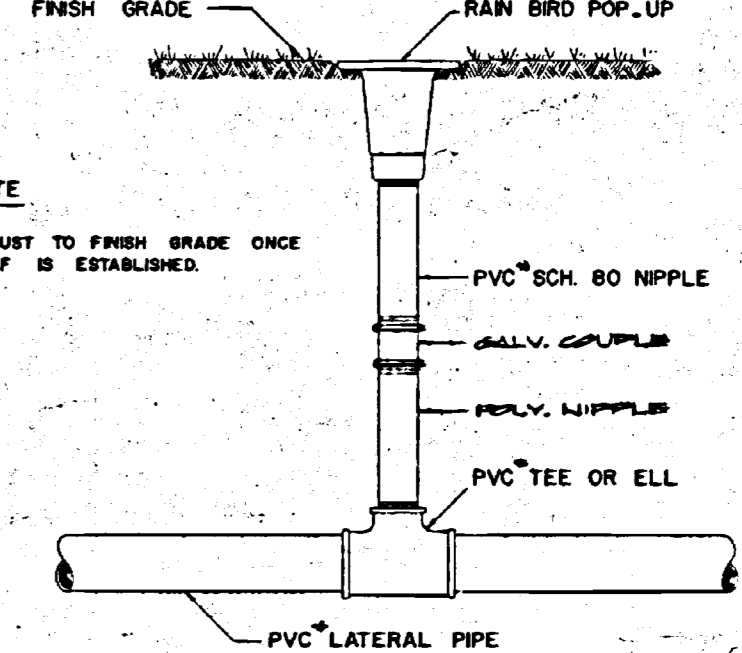

TYPICAL POP UP DETAIL

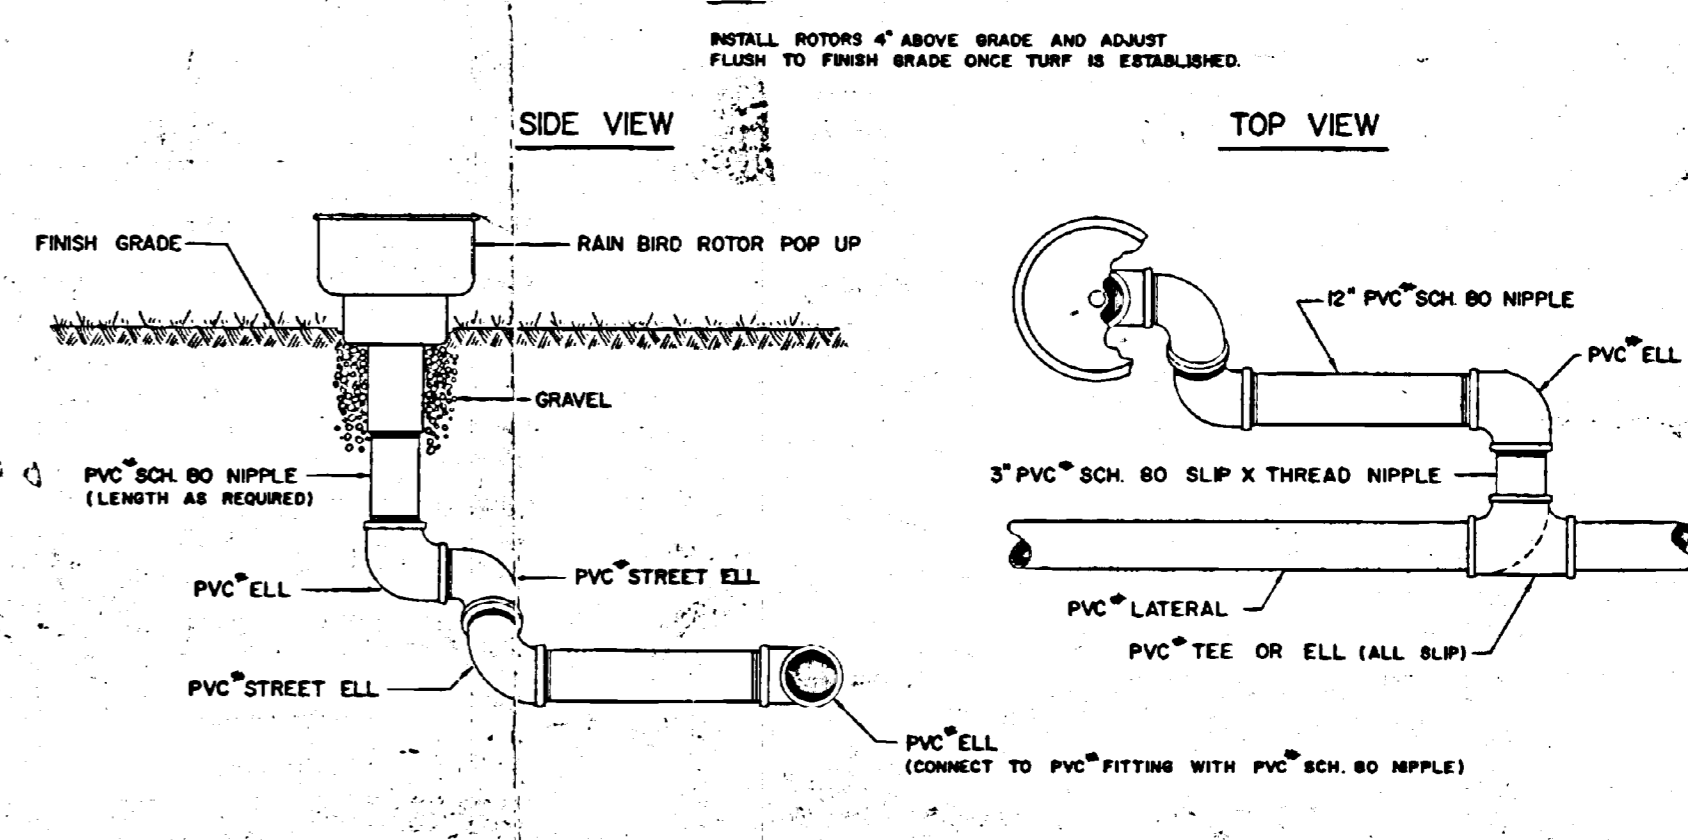

TYPICAL SWING JOINT RISER ASSEMBLY DETAIL

- GENERAL NOTES:**
- ALL PVC PIPE & FITTINGS INDICATED SHALL BEE CHANGED TO GALVANIZED.
  - LIMIT OF CONTRACT (SEE SHEET L1) DOES NOT APPLY TO SPRINKLER PLAN.

NOTE:  
ALL ITEMS MARKED IN RED SHALL NOT BE INCLUDED IN THIS CONTRACT.

KEN SCHMIDT  
WEST COAST LANDSCAPE  
941-2057

TOMY RODRIGUES  
374-0599

SPRINKLER PLAN


CUPERTINO CITY HALL  
S.E. CORNER OF RODRIGUES & TORRE, CUPERTINO, CALIFORNIA

SPRINKLER PLAN

WILFRED E. BLESSING A.I.A.  
ARCHITECT & LANDSCAPE ARCHITECT

1190 COLEMAN AVENUE  
SAN JOSE, CALIFORNIA

2020

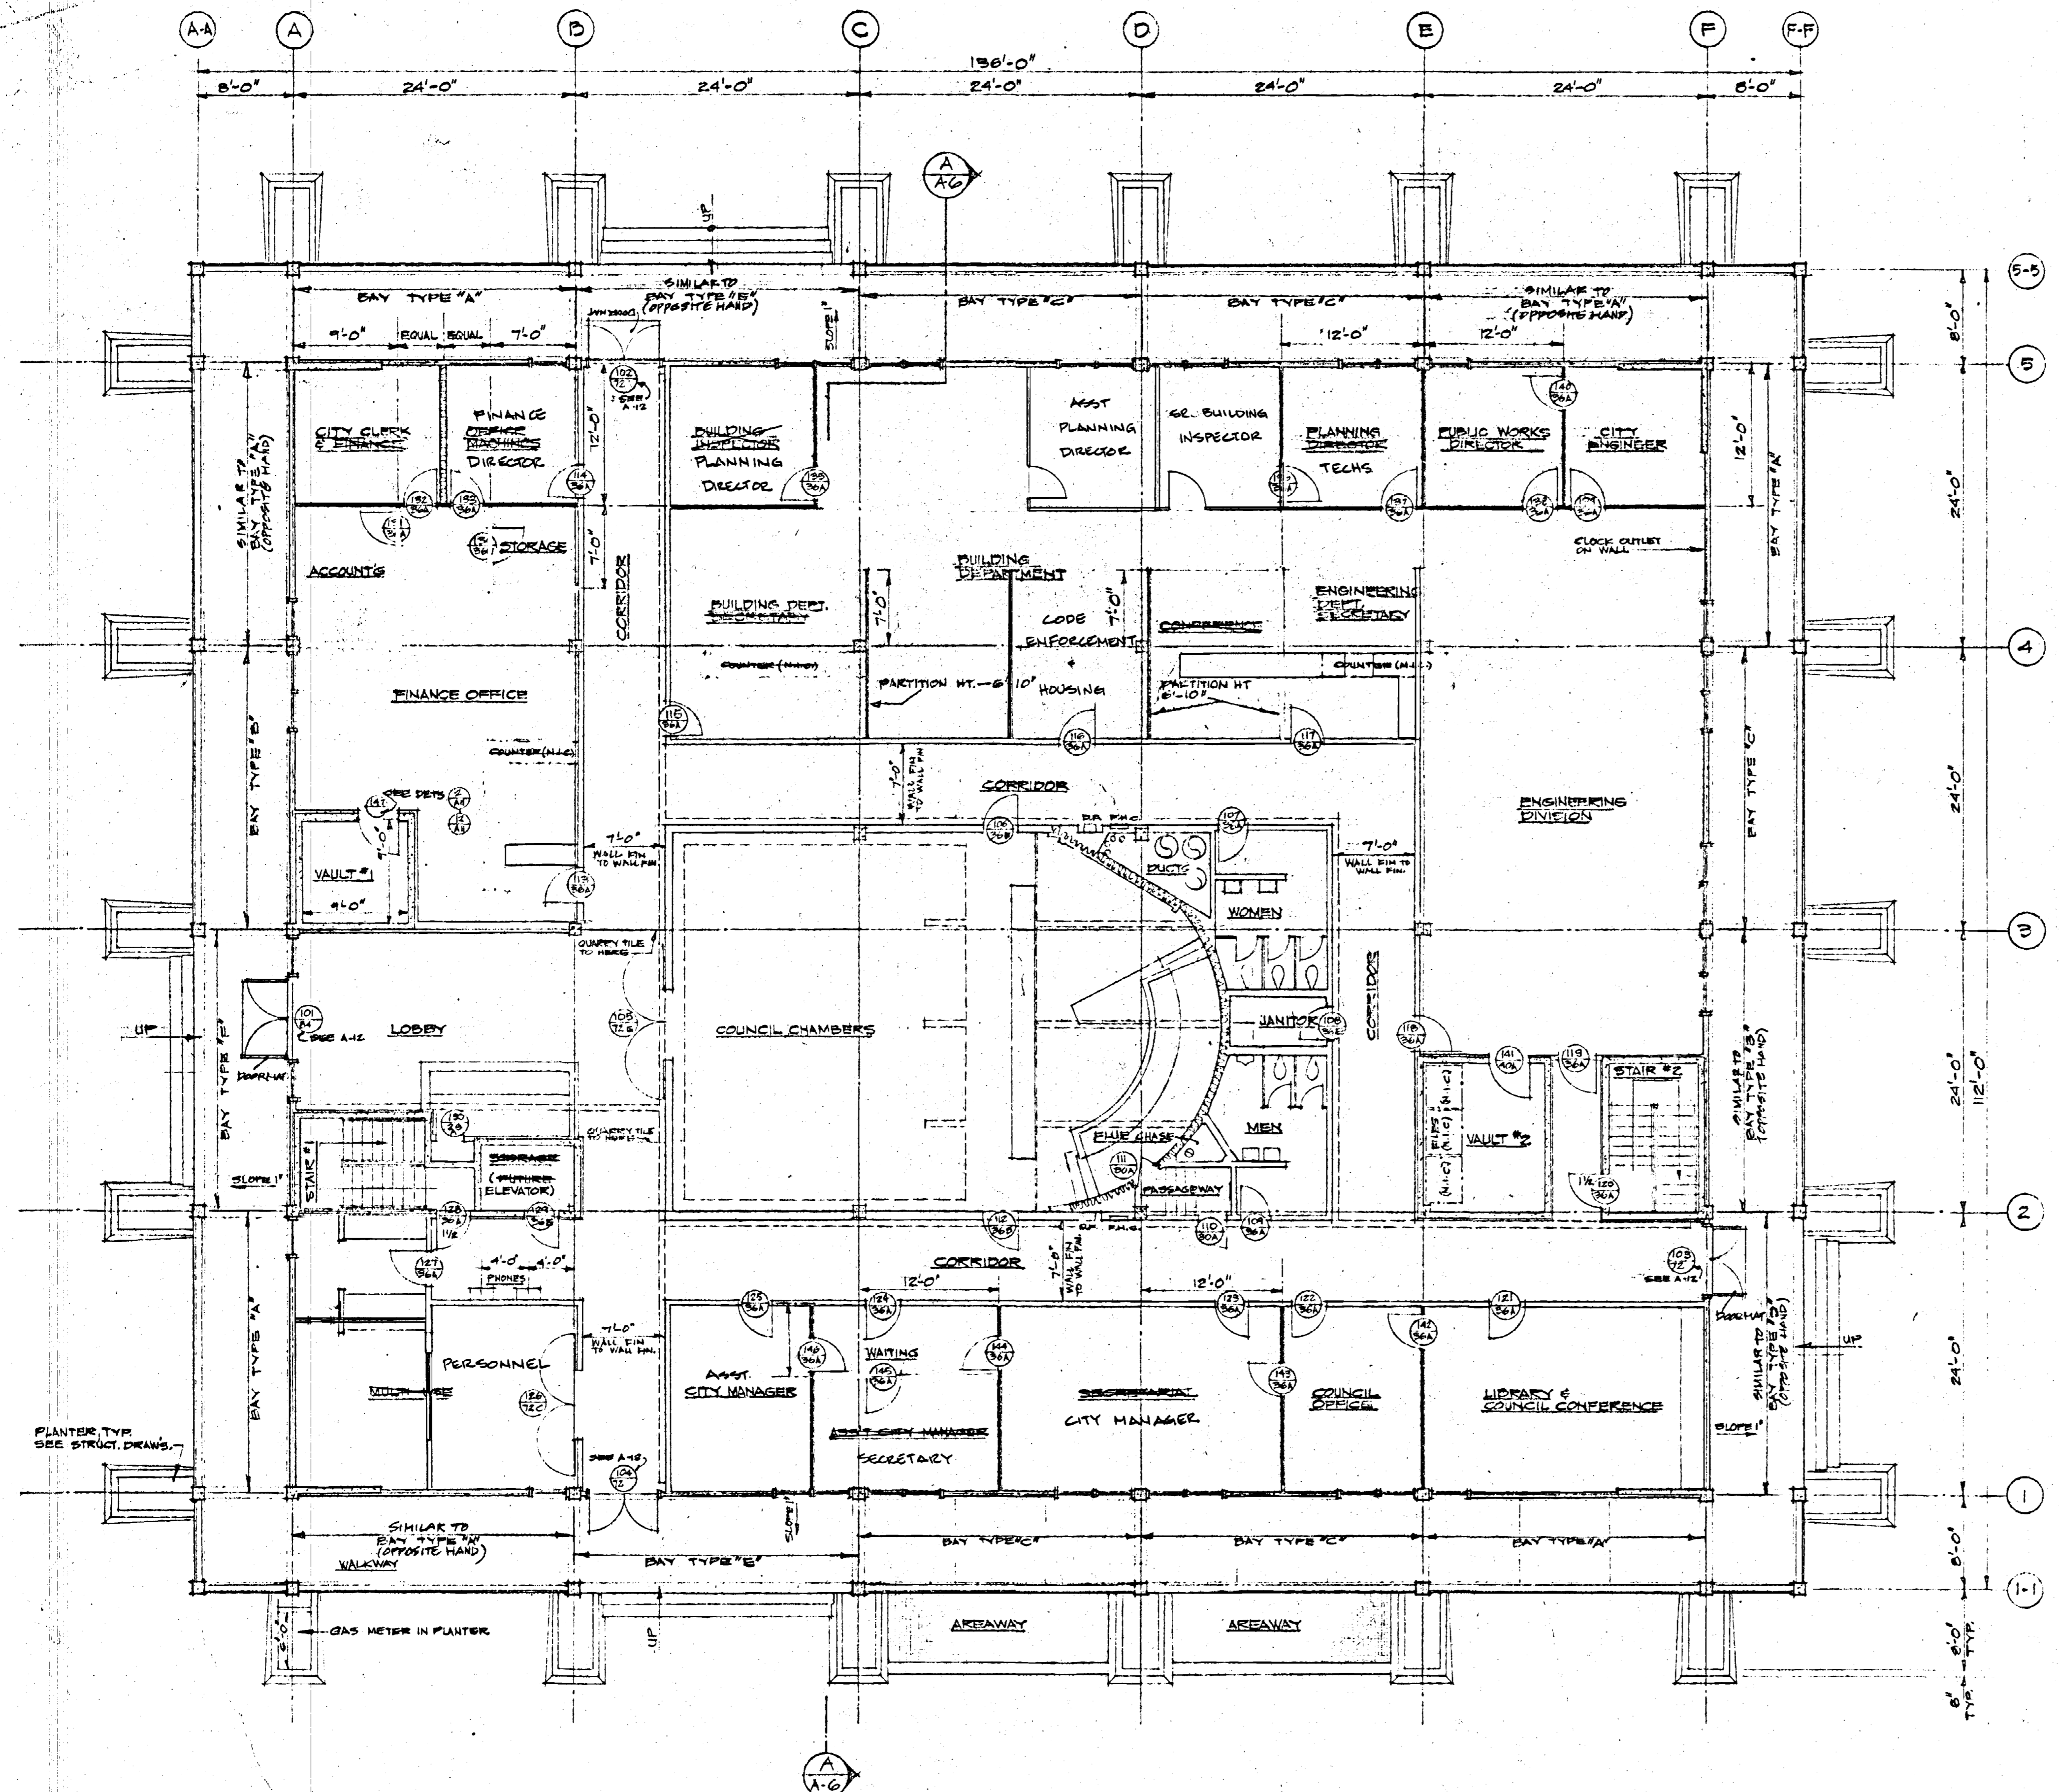

MAIN FLOOR PLAN  
SCALE: 1/8" = 1'-0"

TYPE	REMARKS	TYPE	REMARKS
A	SOLID CORE WOOD	C	SOLID CORE WOOD
B	SPECIAL JAMB FOR CLOSER	D	METAL DOOR WITH FUSIBLE LINK LOUVER, SEE A-15
		E	SOLID CORE WOOD WITH LOUVER F.D. ON DOOR 108, 129
		F	METAL DOOR

115 — DOOR NUMBER, SEE ALSO HARDWARE SCHEDULE.  
36A — DOOR TYPE, SEE ABOVE.  
1 1/2 — LABEL FOR FIRE DOORS, IN HOURS.  
DOOR WIDTH, IN INCHES, S.C.  
ALL DOORS 1 3/4" THICK

DOOR SCHEDULE

- SYMBOLS:
- [Symbol] STUD WALL
  - [Symbol] STAGGERED STUD WALL, W/ 3" INSULATION WOVEN BETWEEN STUDS
  - [Symbol] CONCRETE
  - [Symbol] MOVABLE PARTITIONS

NOTES:  
FOR EXTERIOR WALL BAY DIMENSIONS & DETAILS, SEE A-12.

ENLARGED PLANS:  
A-7 LOBBY, MULTI-USE, VAULTS & STAIRS.  
A-8 COUNCIL CHAMBERS, LIBRARY & COUNCIL CONF.  
A-16 AREAWAYS & TRANSFORMER VAULT.

PLAN SYMBOLS & NOTES

DRAWN: [Signature] CHECKED: [Signature] DATE: 02/11/55. REVISED:

WILFRED E. BLESSING A.I.A.  
ARCHITECT & LANDSCAPE ARCHITECT  
1835 THE ALAMEDA  
SAN JOSE, CALIFORNIA 95126


CUPERTINO CITY HALL  
S.E. CORNER OF RODRIGUES & TORRE, CUPERTINO, CALIFORNIA

MAIN FLOOR PLAN.

CITY HALL MAIN FLOOR PLAN 51, 045

PLANT LIST INCLUDED IN CONTRACT			PLANT LIST NOT IN CONTRACT		
QTY	NAME	COMMON NAME	QTY	NAME	COMMON NAME
0	CINNAMOMUM CAMPHORA	CAMPBELL'S TREE	20	COSEUMASTRUM OFFICINALE	CHAMBER EDENWADY
10	LIPUIDAMBAR	SWEET GUM	1	ANNUALE	PETUNIAS
10	JUNIPERUS HORIZONTALIS	CREEPING JUNIPER	1	ACACIA MELANOXYLON	BLACKWOOD ACACIA
10	JUNIPERUS SABINA	TAMARISK JUNIPER	1	CECIDIUM CECIDIA	CECIDIUM TREE
10	DAPHILEPIS INDICA	PINK INDIA HAWTHORNE	1	CEATAEQUA LAVULUS	CECIDIUM HAWTHORNE
10	HYPERICUM CALYCINUM	AARON'S BEARD	1	LEUCALYPTUS CITRUS	LEMON SCENTED GUM
			1	LIQUIDAMBAR	SWEET GUM
			1	NEGIUM CLEANDER	CLEANDER

PLANT LIST INCLUDED IN CONTRACT			PLANT LIST NOT IN CONTRACT		
QTY	NAME	COMMON NAME	QTY	NAME	COMMON NAME
1	ACACIA MELANOXYLON	BLACKWOOD ACACIA	1	DAPHILEPIS INDICA	PINK INDIA HAWTHORNE
1	CECIDIUM CECIDIA	CECIDIUM TREE	1	HYPERICUM CALYCINUM	AARON'S BEARD
1	CINNAMOMUM CAMPHORA	CAMPBELL'S TREE	1	TRACHELOSPEZUM	SWEET JASMINE
1	CEATAEQUA LAVULUS	CECIDIUM HAWTHORNE			
1	LIQUIDAMBAR	SWEET GUM			
1	LEUCALYPTUS CITRUS	LEMON SCENTED GUM			
1	LIQUIDAMBAR	SWEET GUM			
1	NEGIUM CLEANDER	CLEANDER			

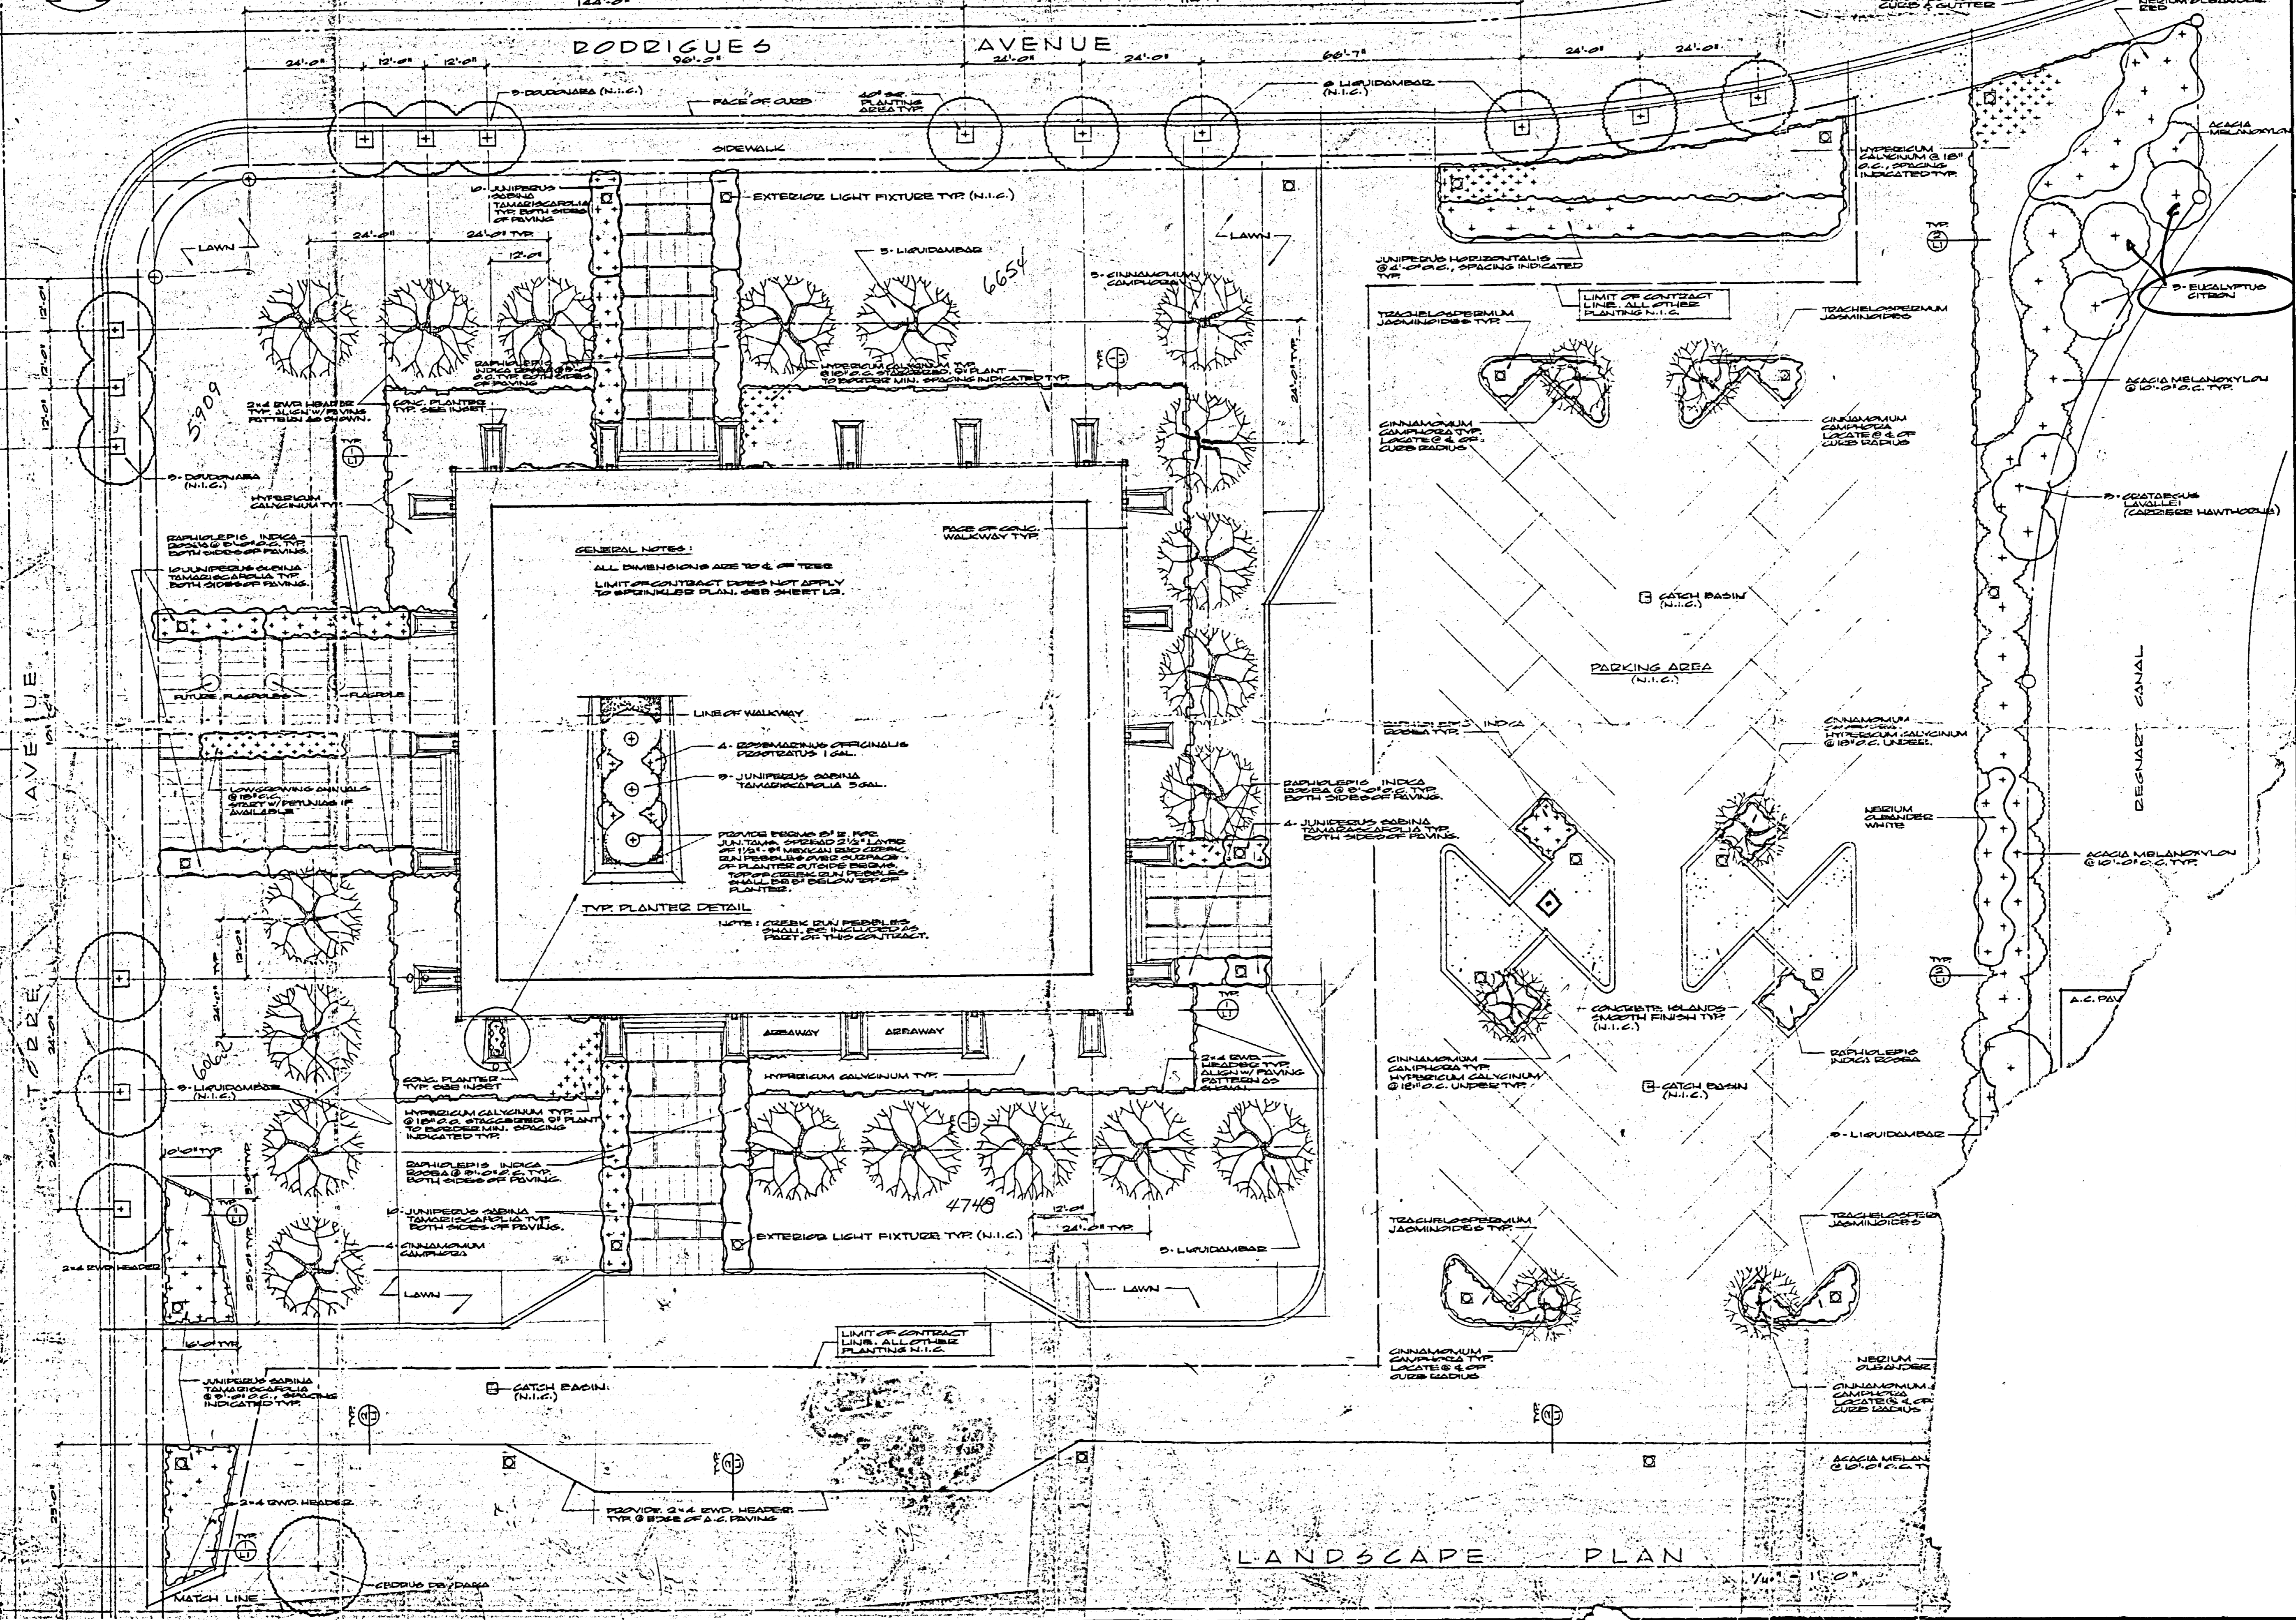

LANDSCAPE PLAN


WILFRED E. BLESSING A.I.A.  
 ARCHITECT & LANDSCAPE ARCHITECT  
 190 COLEMAN AVENUE  
 SAN JOSE, CALIFORNIA 95110  
 WED  
 CUPERINO CITY HALL  
 S.E. CORNER OF RODRIGUES & TORRE CUPERTINO, CALIFORNIA  
 LANDSCAPING PLAN  
 51,045

### IRRIGATION LEGEND


- △ RAIN BIRD No. A7-171 STANDARD PART CIRCLE SPRINKLER 1/2" I.P.S.
- ▲ " " No. A7-171 OVERSIZE " " " "
- " " No. A7-171 STANDARD FULL " " " "
- " " No. A7-171 UNDERSIZE " " " "
- ⊙ CHAMPION 300 SERIES ANGLE CONTROL VALVE.
- CLASS 160 TYPE 1220 PVC PLASTIC PIPE.
- - - SCHEDULE 40 TYPE 1220 PVC PLASTIC PIPE.
- CALCO 100 LK LOOSE KEY HOSE FIBB 3/4" I.P.S.

### IRRIGATION NOTES


1. SYSTEM DESIGNED TO OPERATE ON 45 P.S.I. FROM DISCHARGE OF REDUCING VALVE. SET VALVE ACCORDINGLY.
2. INSTALL A GEE No. 905 ATMOSPHERIC VACUUM BREAKER ON THE DISCHARGE SIDE OF EACH CONTROL VALVE ACCORDING TO LOCAL CODE.
3. PROVIDE 1-30" SPRINKLER VALVE KEY.
4. SET PART CIRCLE SPRINKLERS 1'-6" FROM EDGE OF CURB.
5. STAKE SPRINKLERS ALONG THE EDGE OF CURB 24"x1/2" GALV. PIPE & 2 DOUBLE WIRE TIES.

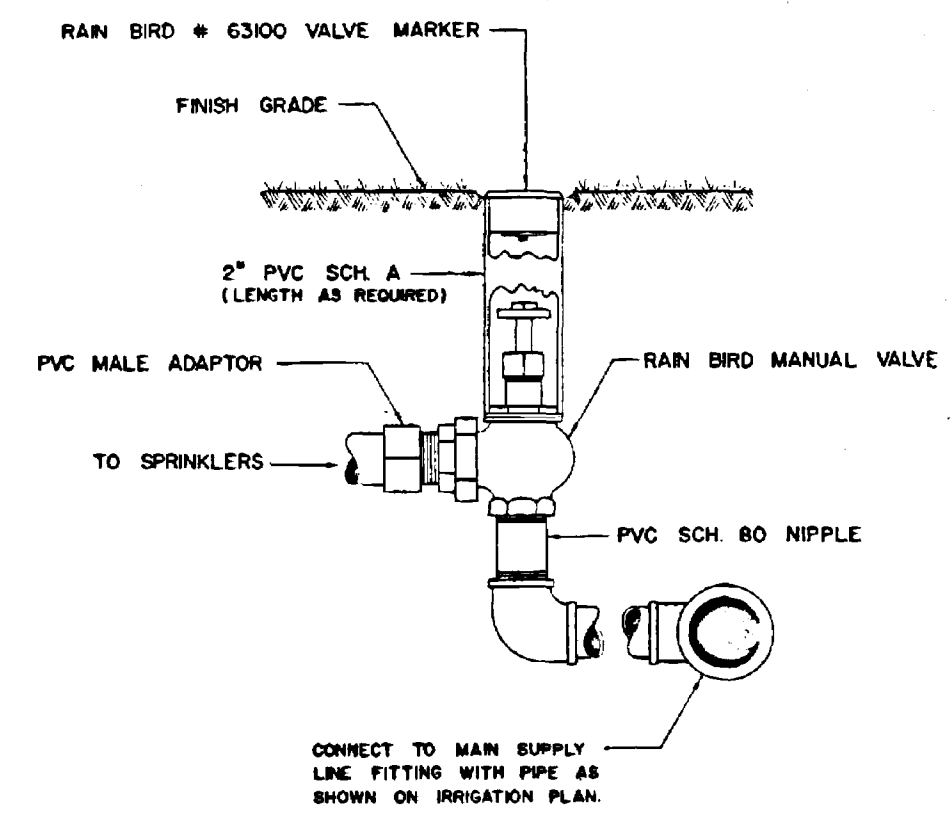

TYPICAL MANUAL VALVE ASSEMBLY DETAIL

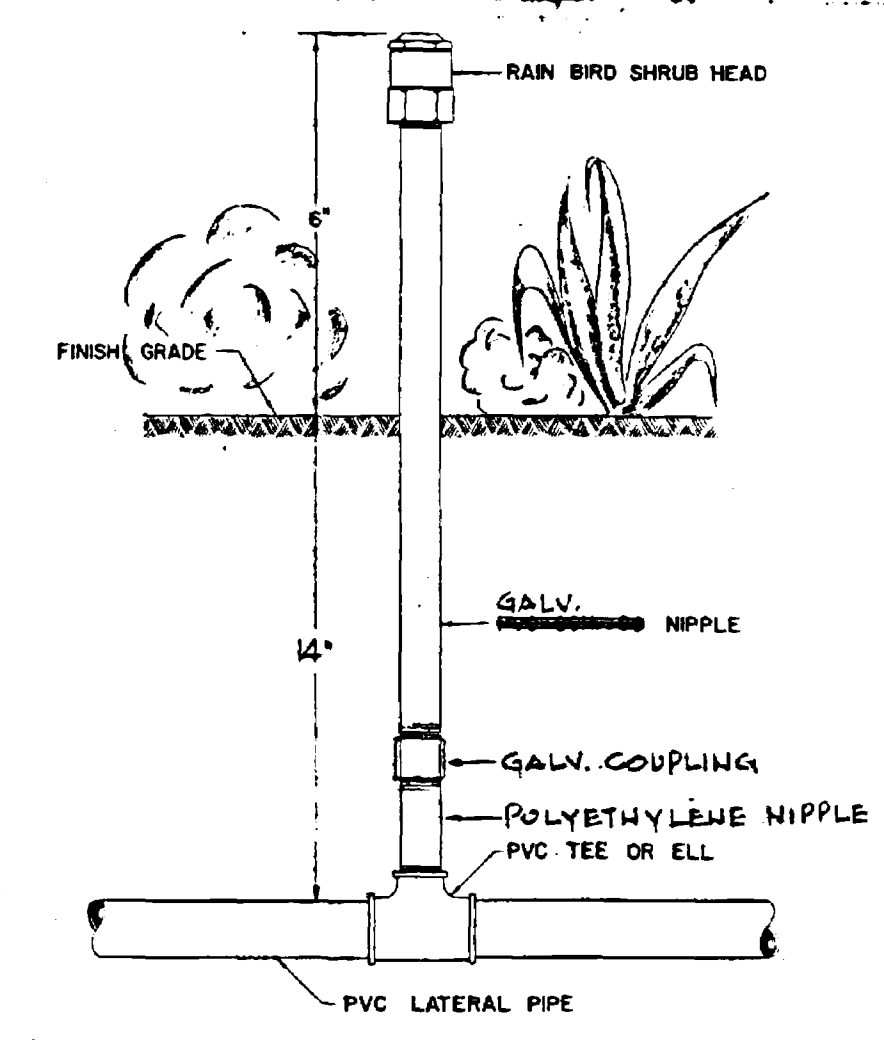

TYPICAL SHRUB HEAD DETAIL

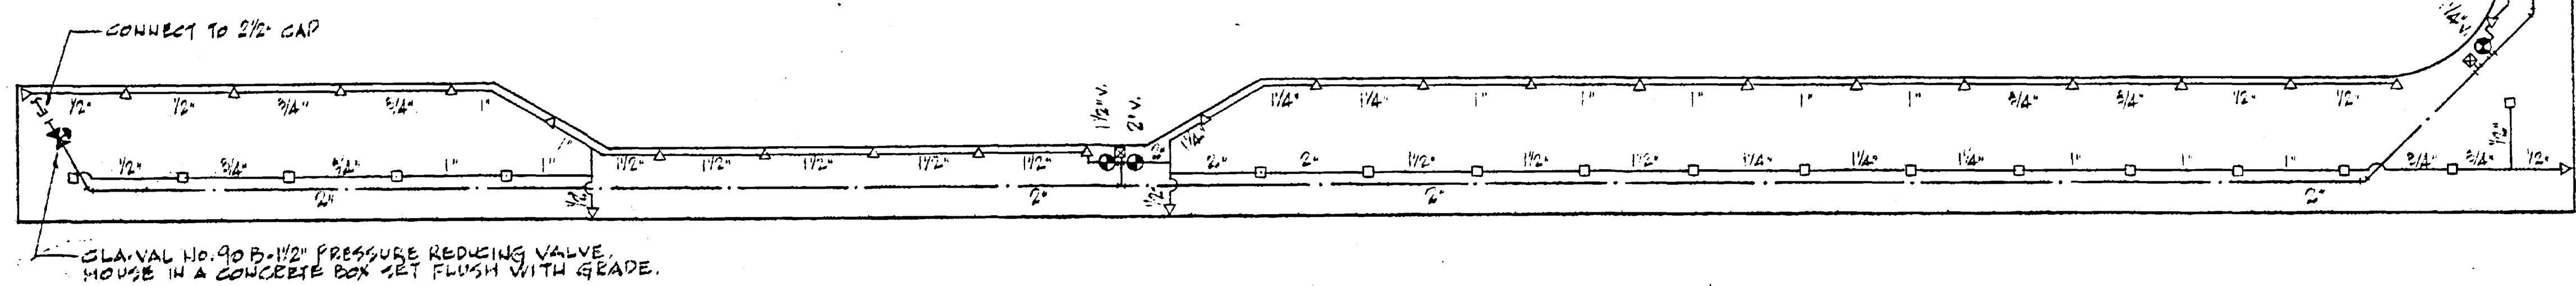


A MANUAL IRRIGATION SYSTEM FOR  
**CUPERTINO CITY HALL**  
 CUPERTINO - CALIFORNIA  
 SCALE 1" = 20'-0"

## IRRIGATION LEGEND


- △ RAIN BIRD No. A7-171 STANDARD PART CIRCLE SPRINKLER 1/2" I.P.S.
- ▲ " " No. A7-171 OVERSIZE " " " "
- " " No. A7-171 STANDARD FULL " " " "
- " " No. A7-171 UNDERSIZE " " " "
- ⊕ CHAMPION 300 SERIES ANGLE CONTROL VALVE.
- CLASS 160 TYPE 1220 PVC PLASTIC PIPE.
- - - SCHEDULE 40 TYPE 1220 PVC PLASTIC PIPE.
- CALCO 100 LK LOOSE KEY HOSE FITT 3/4" I.P.S.

## IRRIGATION NOTES


1. SYSTEM DESIGNED TO OPERATE ON 45 P.S.I. FROM DISCHARGE OF REDUCING VALVE. SET VALVE ACCORDINGLY.
2. INSTALL A GEE No. 905 ATMOSPHERIC VACUUM BREAKER ON THE DISCHARGE SIDE OF EACH CONTROL VALVE ACCORDING TO LOCAL CODE.
3. PROVIDE 1-30" SPRINKLER VALVE KEY.
4. SET PART CIRCLE SPRINKLERS 1'-6" FROM EDGE OF CURB.
5. STAKE SPRINKLERS ALONG THE EDGE OF CURB 24"x1/2" GALV. PIPE & 2 DOUBLE WIRE TIES.

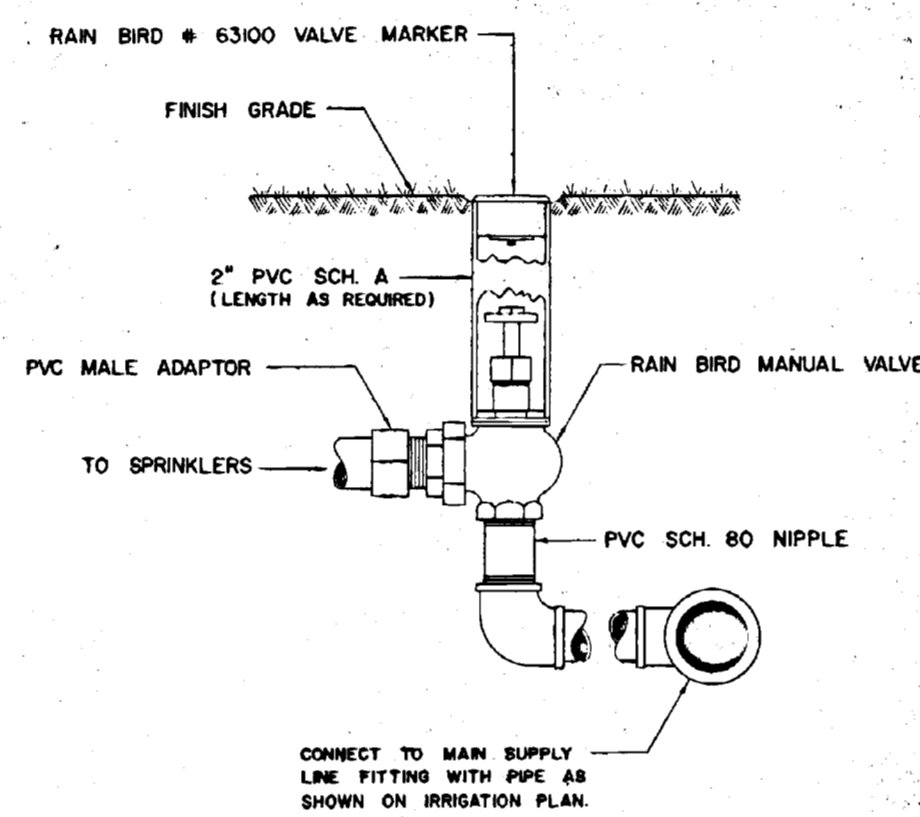



TYPICAL MANUAL VALVE ASSEMBLY DETAIL

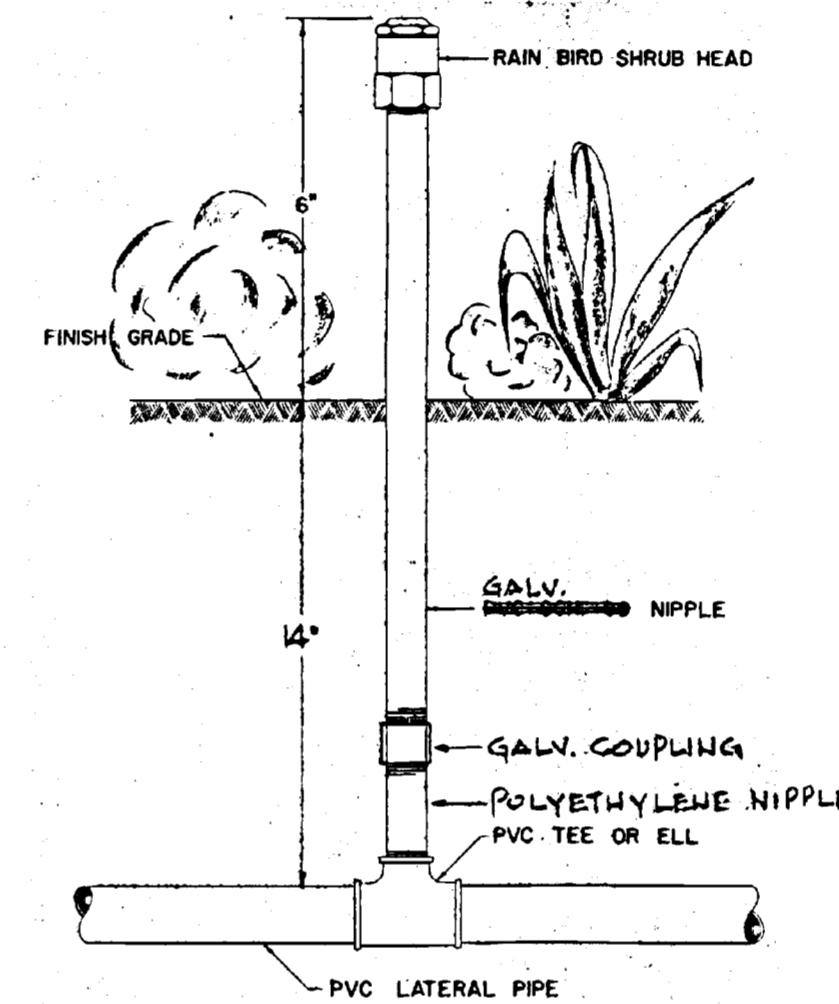

TYPICAL SHRUB HEAD DETAIL

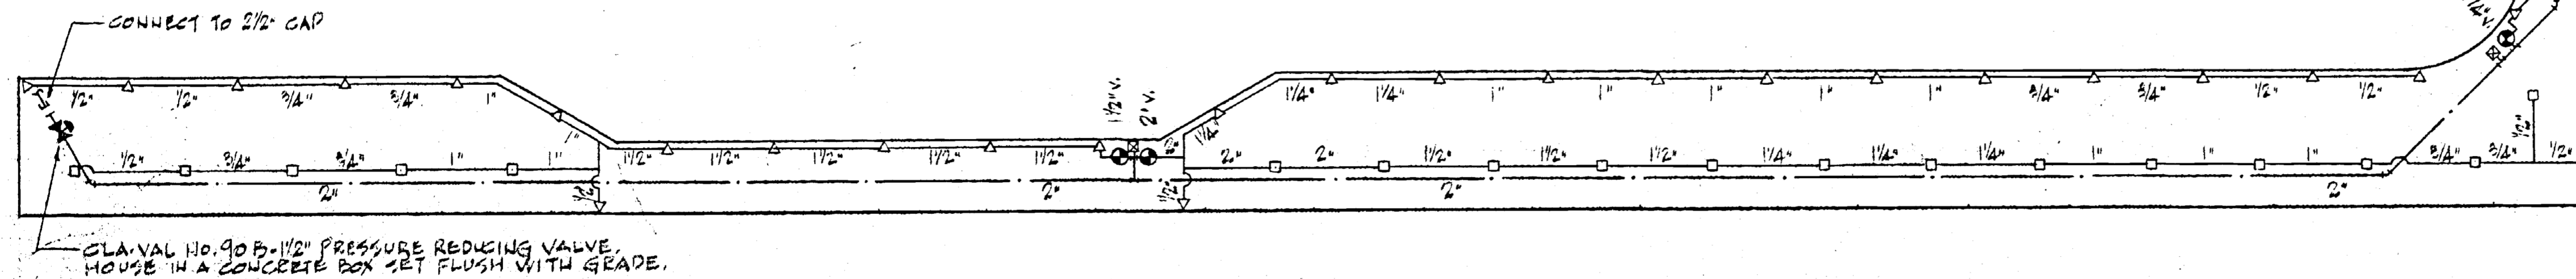

A MANUAL IRRIGATION SYSTEM FOR  
CUPERTINO CITY HALL  
 CUPERTINO - CALIFORNIA  
 SCALE 1" = 20'-0"

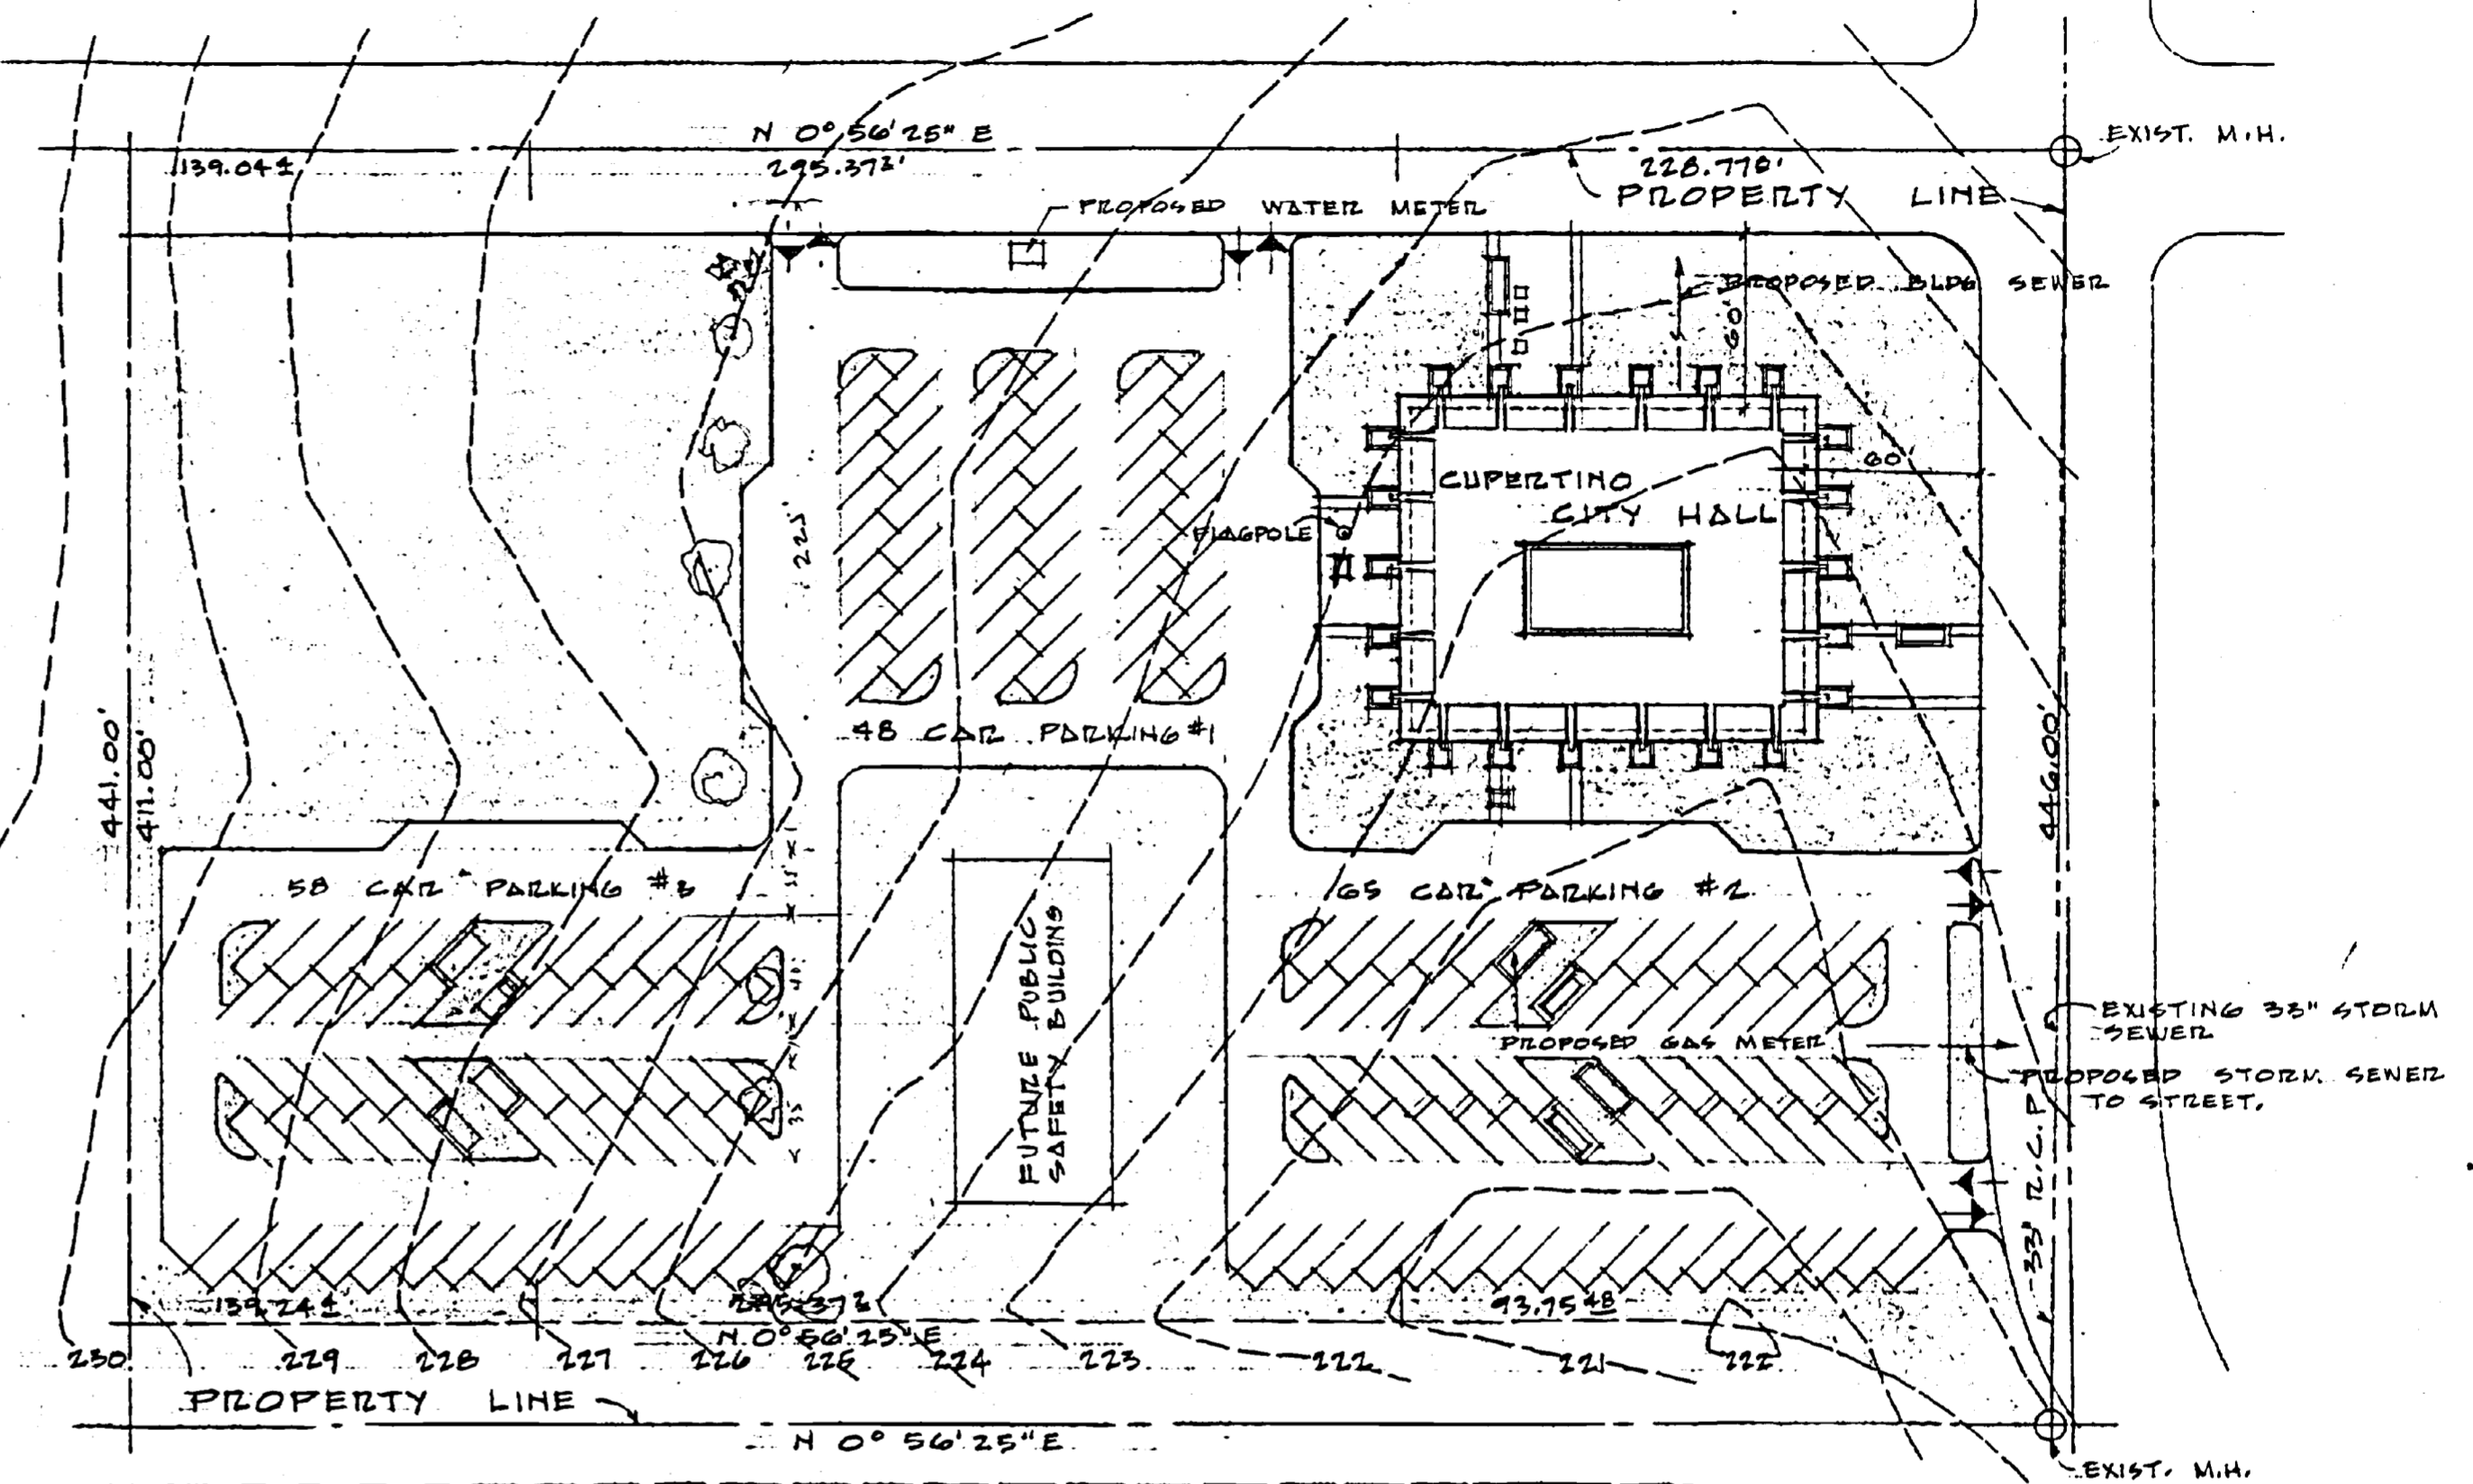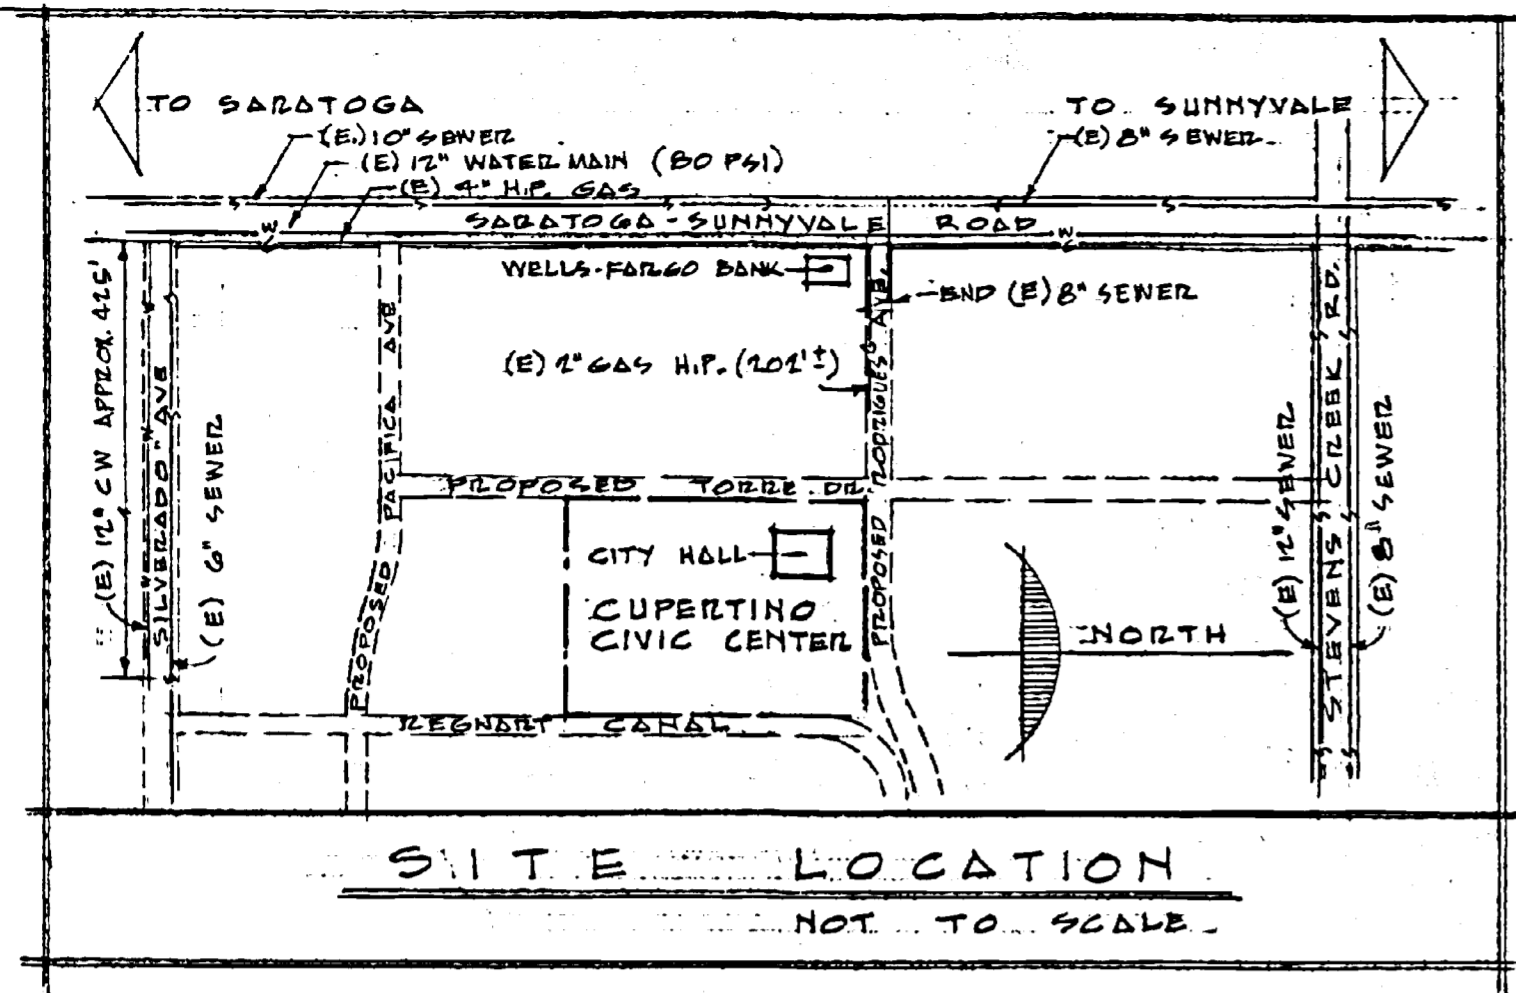

**INDEX OF DRAWINGS**

- A1 PLOT PLAN & LIST OF DRAWINGS
- A2 MAIN FLOOR & BASEMENT PLAN
- A3 EXTERIOR ELEVATIONS
- A4 LONGITUDINAL BUILDING SECTIONS
- A5 TRANSVERSE BUILDING SECTIONS
- M1 MECHANICAL PLANS
- M2 MECHANICAL ROOM
- E1 ELECTRICAL PLOT PLAN
- E2 LIGHTING FLOOR PLANS
- E3 POWER FLOOR PLAN
- E4 FIXTURE SCHEDULE
- S1 BASEMENT & FOUNDATION SCHEMES
- S2 FLOOR FRAMING SCHEME "I"
- S3 FLOOR FRAMING SCHEME "II"
- S4 ROOF FRAMING SCHEME "I" & "II"

**PLOT PLAN**  
SCALE: 1" = 60.0'

PLOT PLAN CONTOURS AND BOUNDARIES REPRODUCED FROM PLAT SURVEY DRAWING FURNISHED APRIL 1963 MAKAY & SOMPS CIVIL ENGINEERS 1003 W. EL CAMINO REAL SUNNYVALE CALIFORNIA

**CUPERTINO CITY HALL**  
S.E. CORNER OF RODRIGUES & TORRE, CUPERTINO, CALIFORNIA

**PLOT PLAN & INDEX OF DRAWINGS**

WILFRED E. BLESSING A.I.A.  
ARCHITECT & LANDSCAPE ARCHITECT



3593 STEVENS CREEK BLVD.  
SAN JOSE 28, CALIFORNIA

DRAWN: ILM  
CHECKED:  
DATE: FEB. 5, 1968

**A1**

10300 Torre-Ave






### IRRIGATION LEGEND


- △ RAIN BIRD No. AT-171 STANDARD PART CIRCLE SPRINKLER 1/2 I.P.S.
- ▲ " " " " OVERSIZE " " " "
- " " " " STANDARD FULL " " " "
- " " " " UNDSIZE " " " "
- ⊕ CHAMPION 300 SERIES ANGLE CONTROL VALVE.
- CLASS 150 TYPE 1220 PVC PLASTIC PIPE.
- - - SCHEDULE 40 TYPE 1220 PVC PLASTIC PIPE.
- GALCO 100LK LOOSE KEY HOSE PIPES 2 1/2" I.P.S.

### IRRIGATION NOTES


1. SYSTEM DESIGNED TO OPERATE ON 45 P.S.I. FROM DISCHARGE OF REDUCING VALVE. SET VALVE ACCORDINGLY.
2. INSTALL A GEE NO. 303 ATMOSPHERIC VACUUM BREAKER ON THE DISCHARGE SIDE OF EACH CONTROL VALVE ACCORDING TO LOCAL CODE.
3. PROVIDE 1-30° SPRINKLER VALVE KEY.
4. SET PART CIRCLE SPRINKLERS 11-6" FROM EDGE OF CURB.
5. STAKE SPRINKLERS ALONG THE EDGE OF CURB 24" 2" GALV PIPE & 2 DOUBLE WIRE TIES.

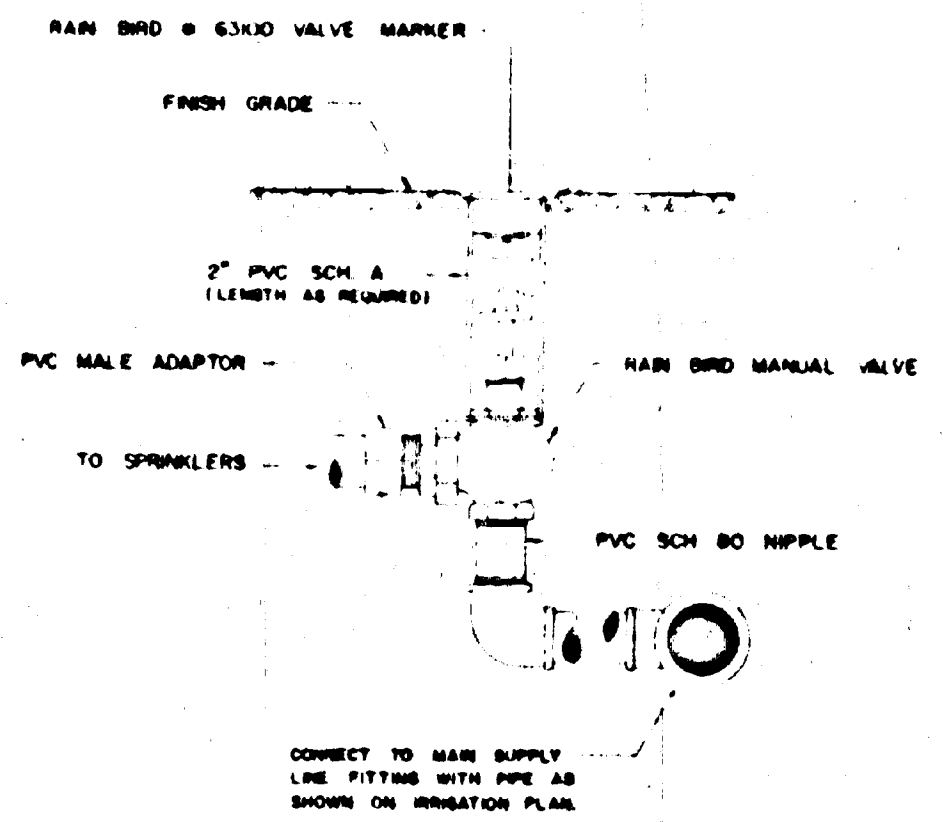

TYPICAL MANUAL VALVE ASSEMBLY DETAIL

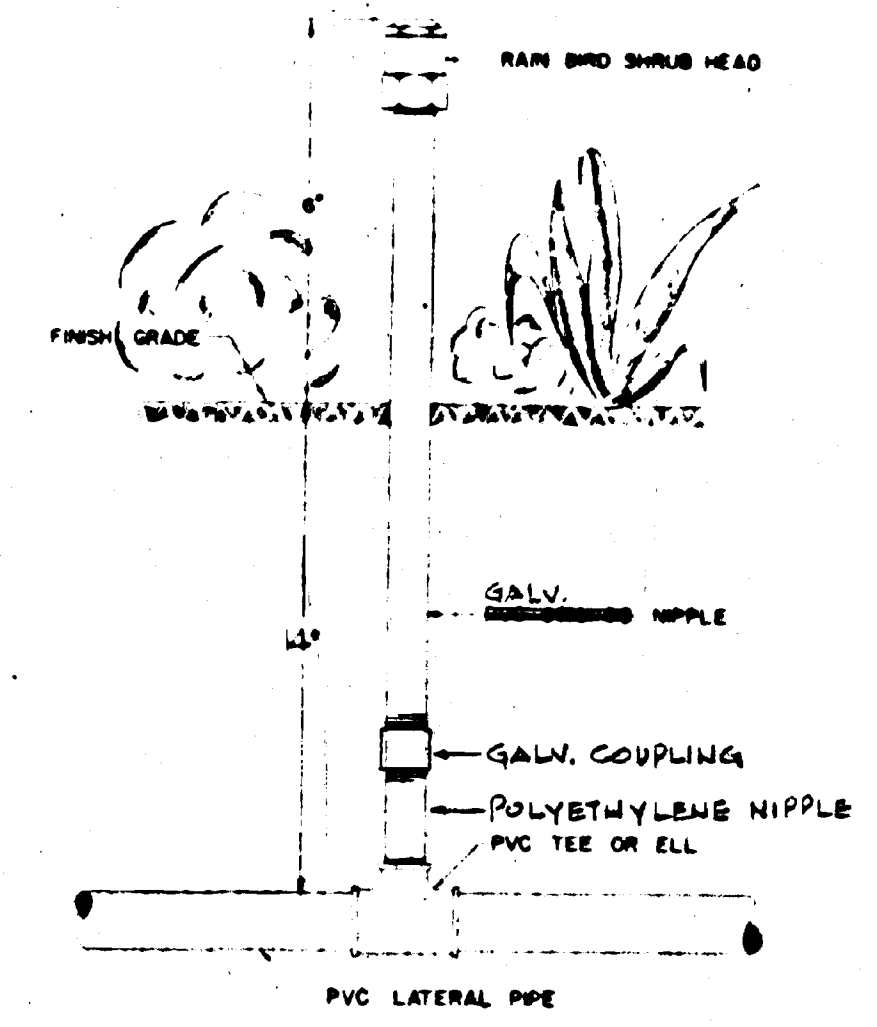



TYPICAL SHRUB HEAD DETAIL

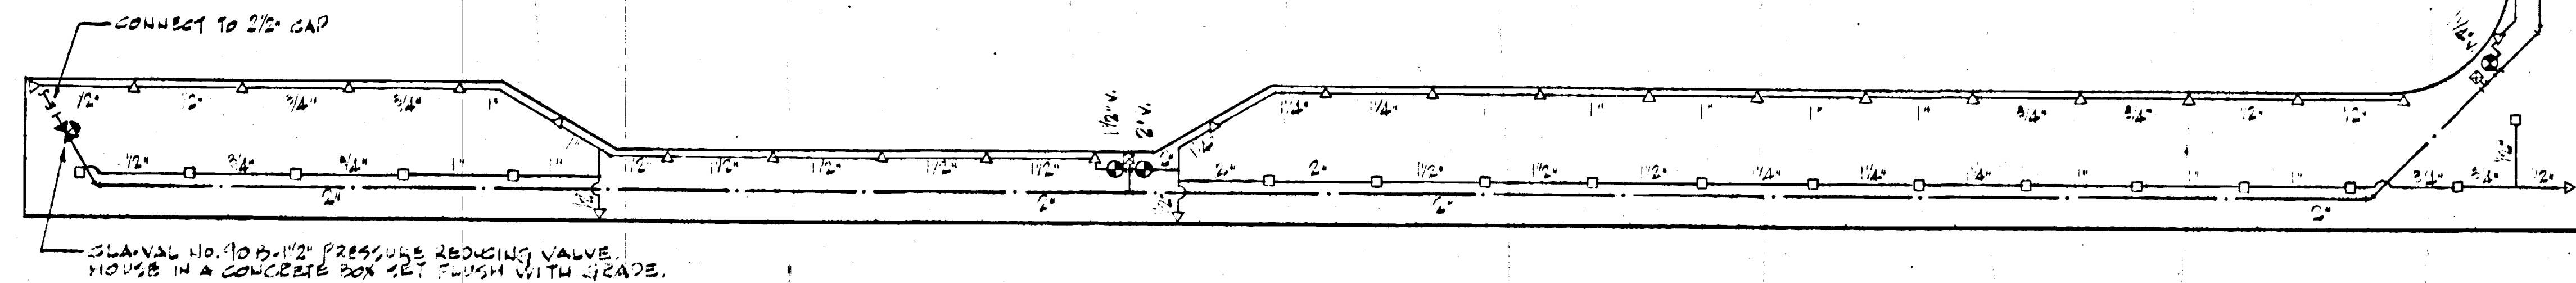

SLAVAL NO. 90 B-1 1/2" PRESSURE REDUCING VALVE HOUSING IN A CONCRETE BOX SET FLUSH WITH GRADE.


A MANUAL IRRIGATION SYSTEM FOR  
**SUPERTINO CITY HALL**  
 SUPERTINO - CALIFORNIA  
 1/2" x 20'-0"



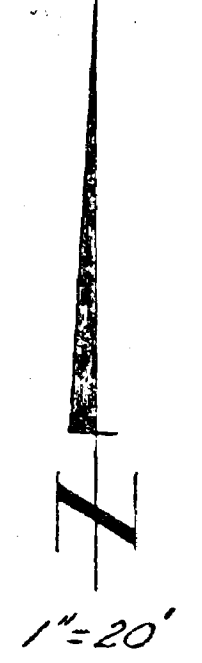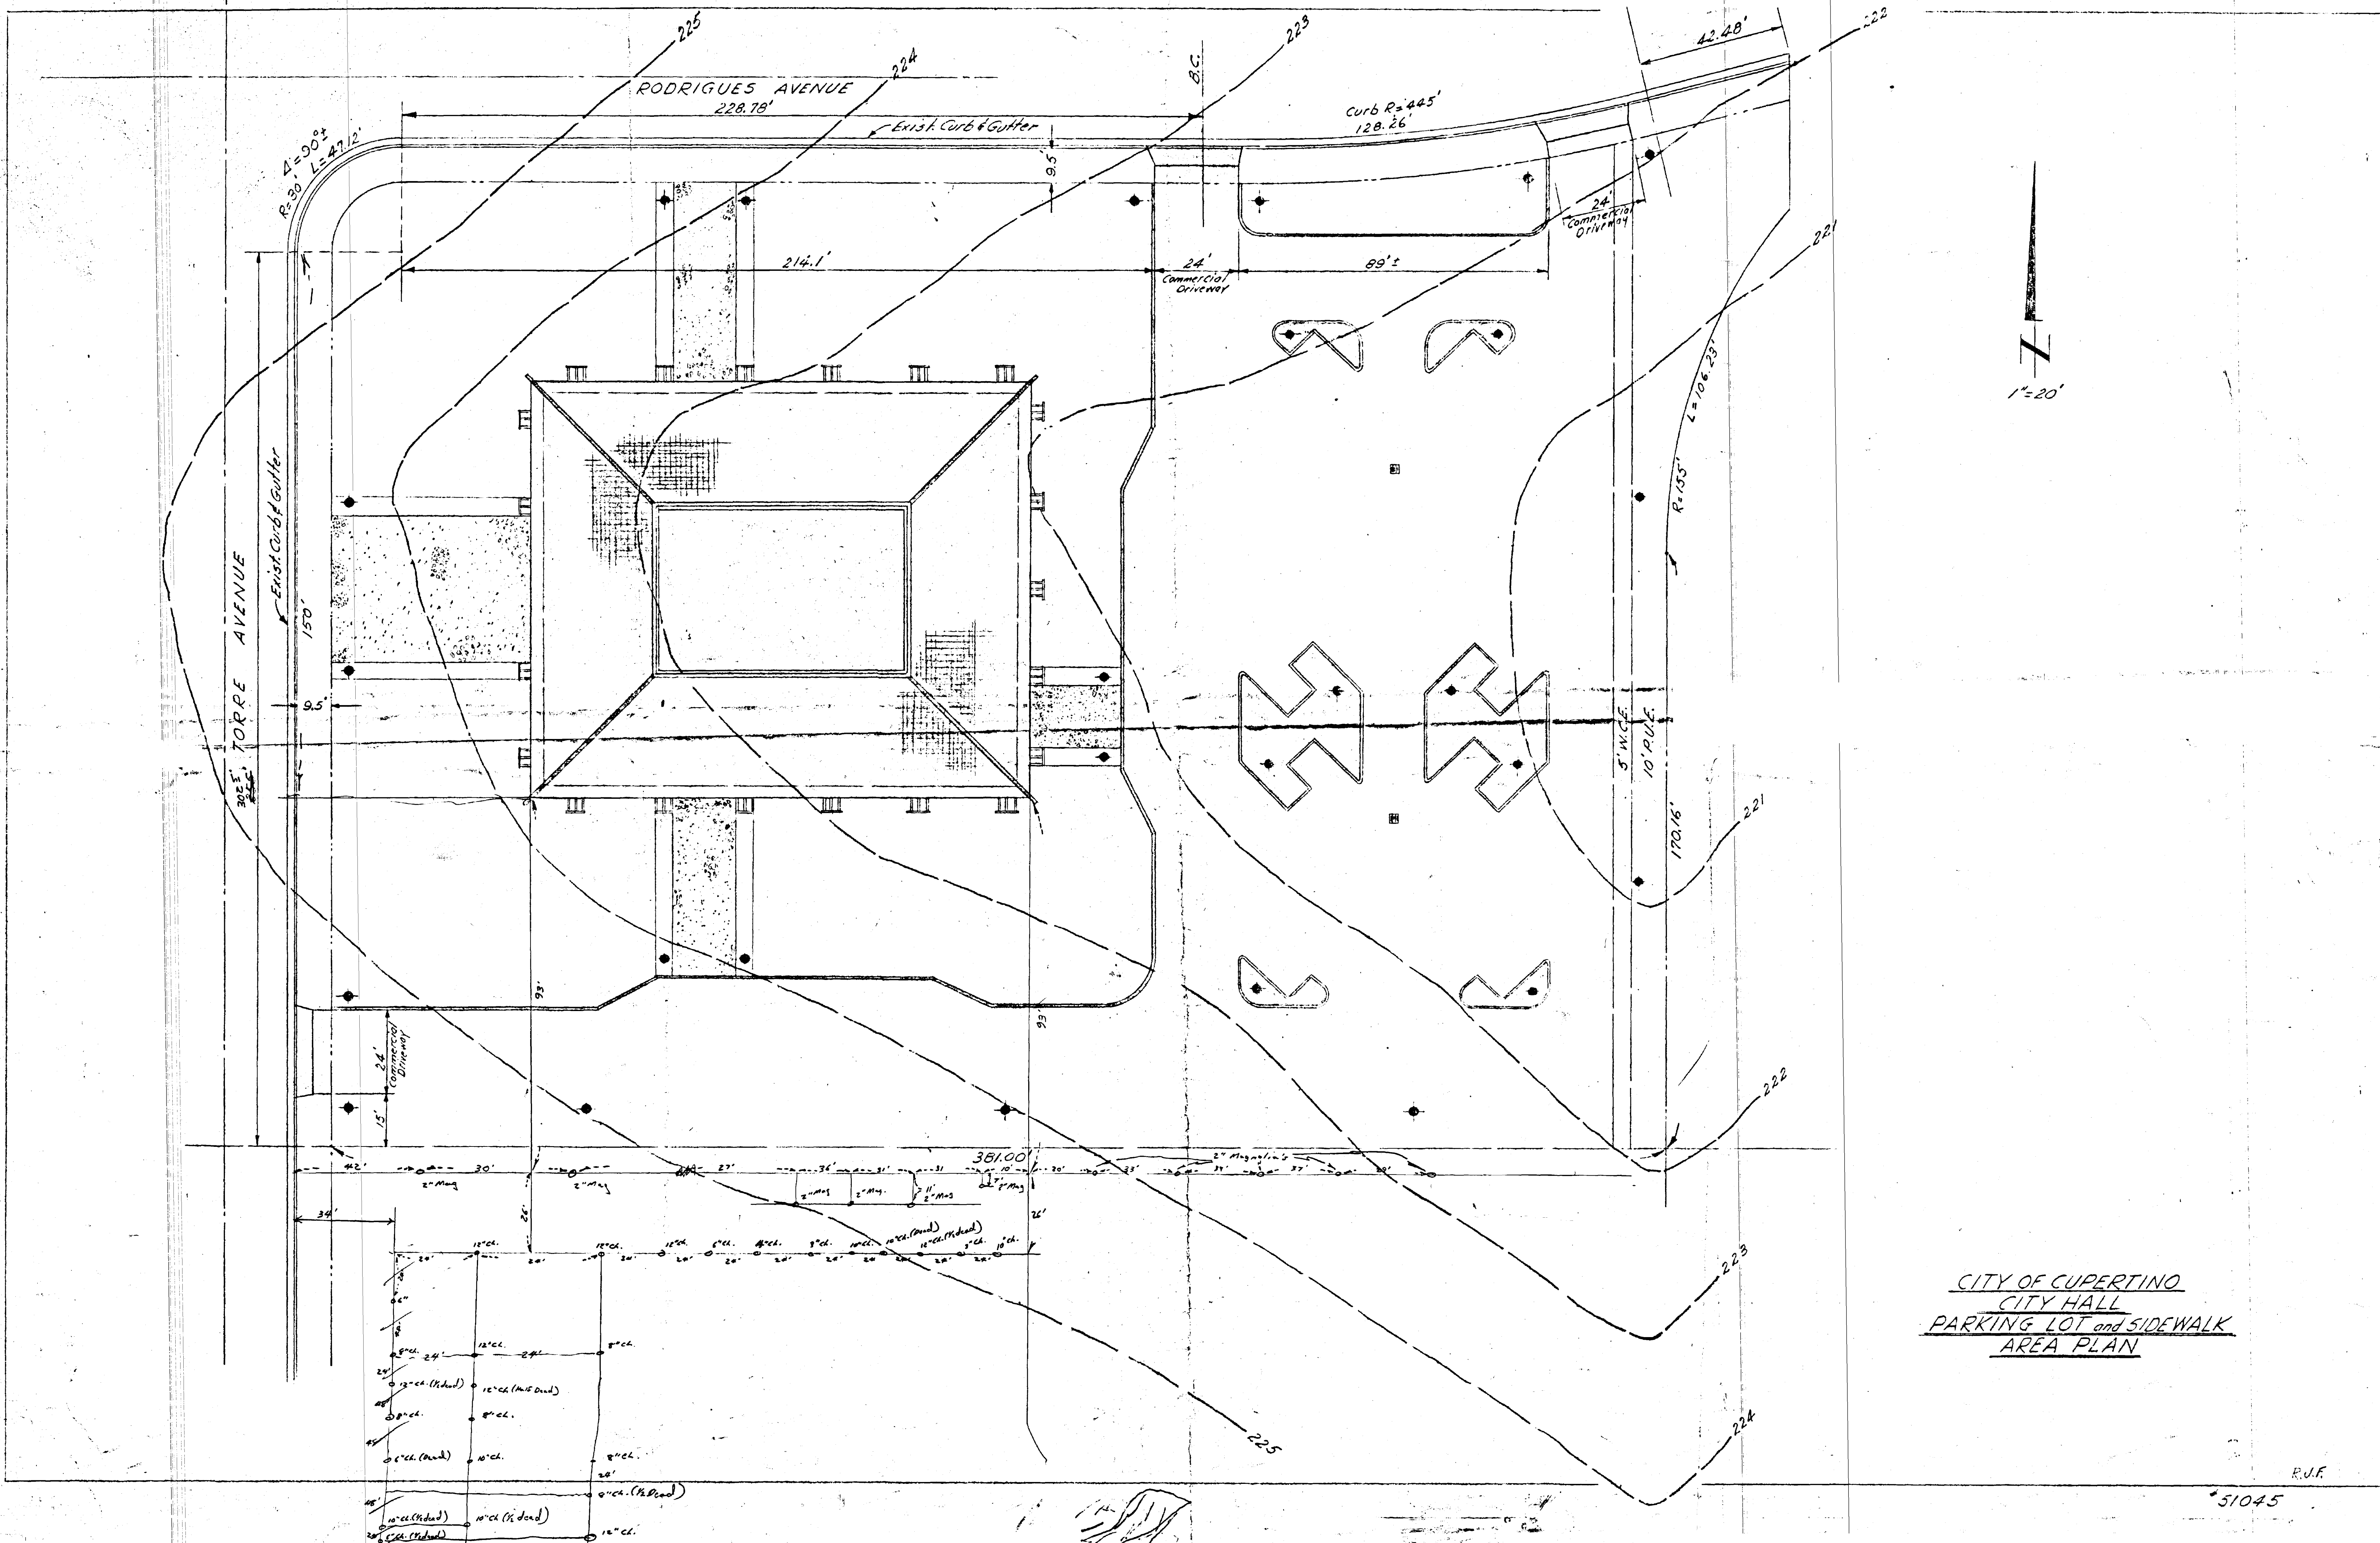


CITY OF CUPERTINO  
 CITY HALL  
 PARKING LOT and SIDEWALK  
 AREA PLAN

R.U.F.  
 51045

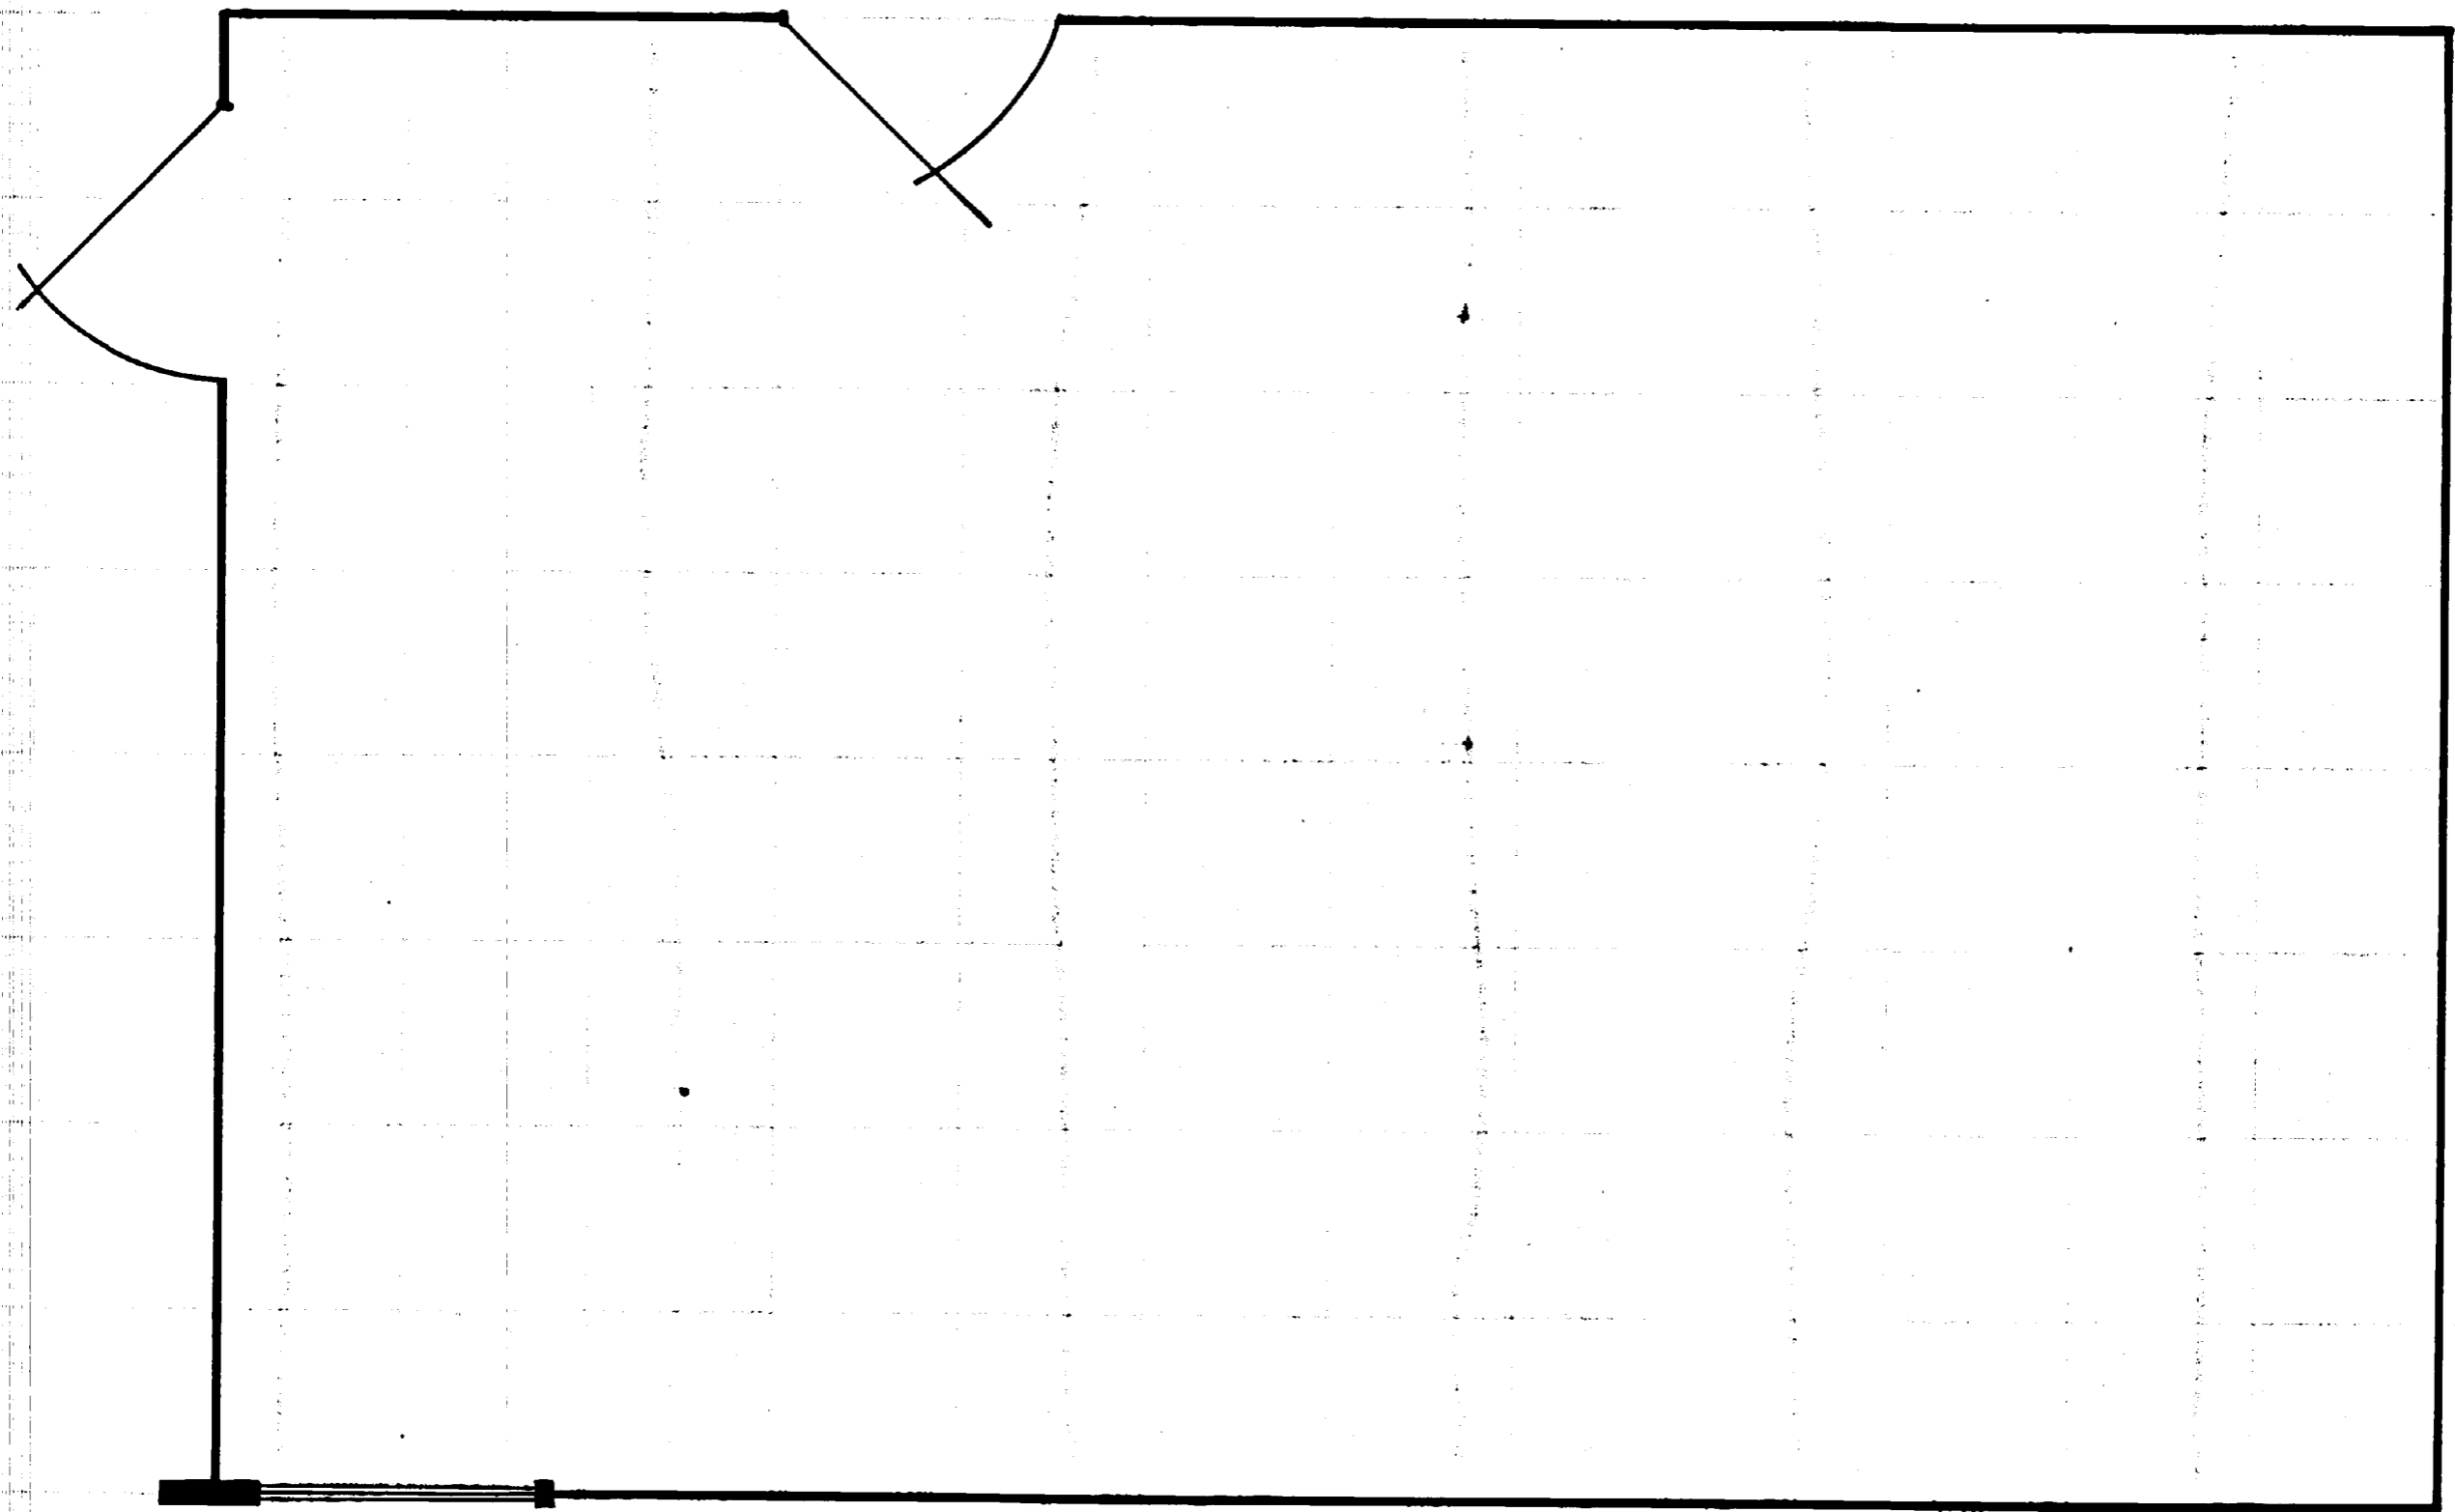

LIBRARY & COUNCIL CONFERENCE

Scale:  $\frac{1}{2}'' = 1'-0''$

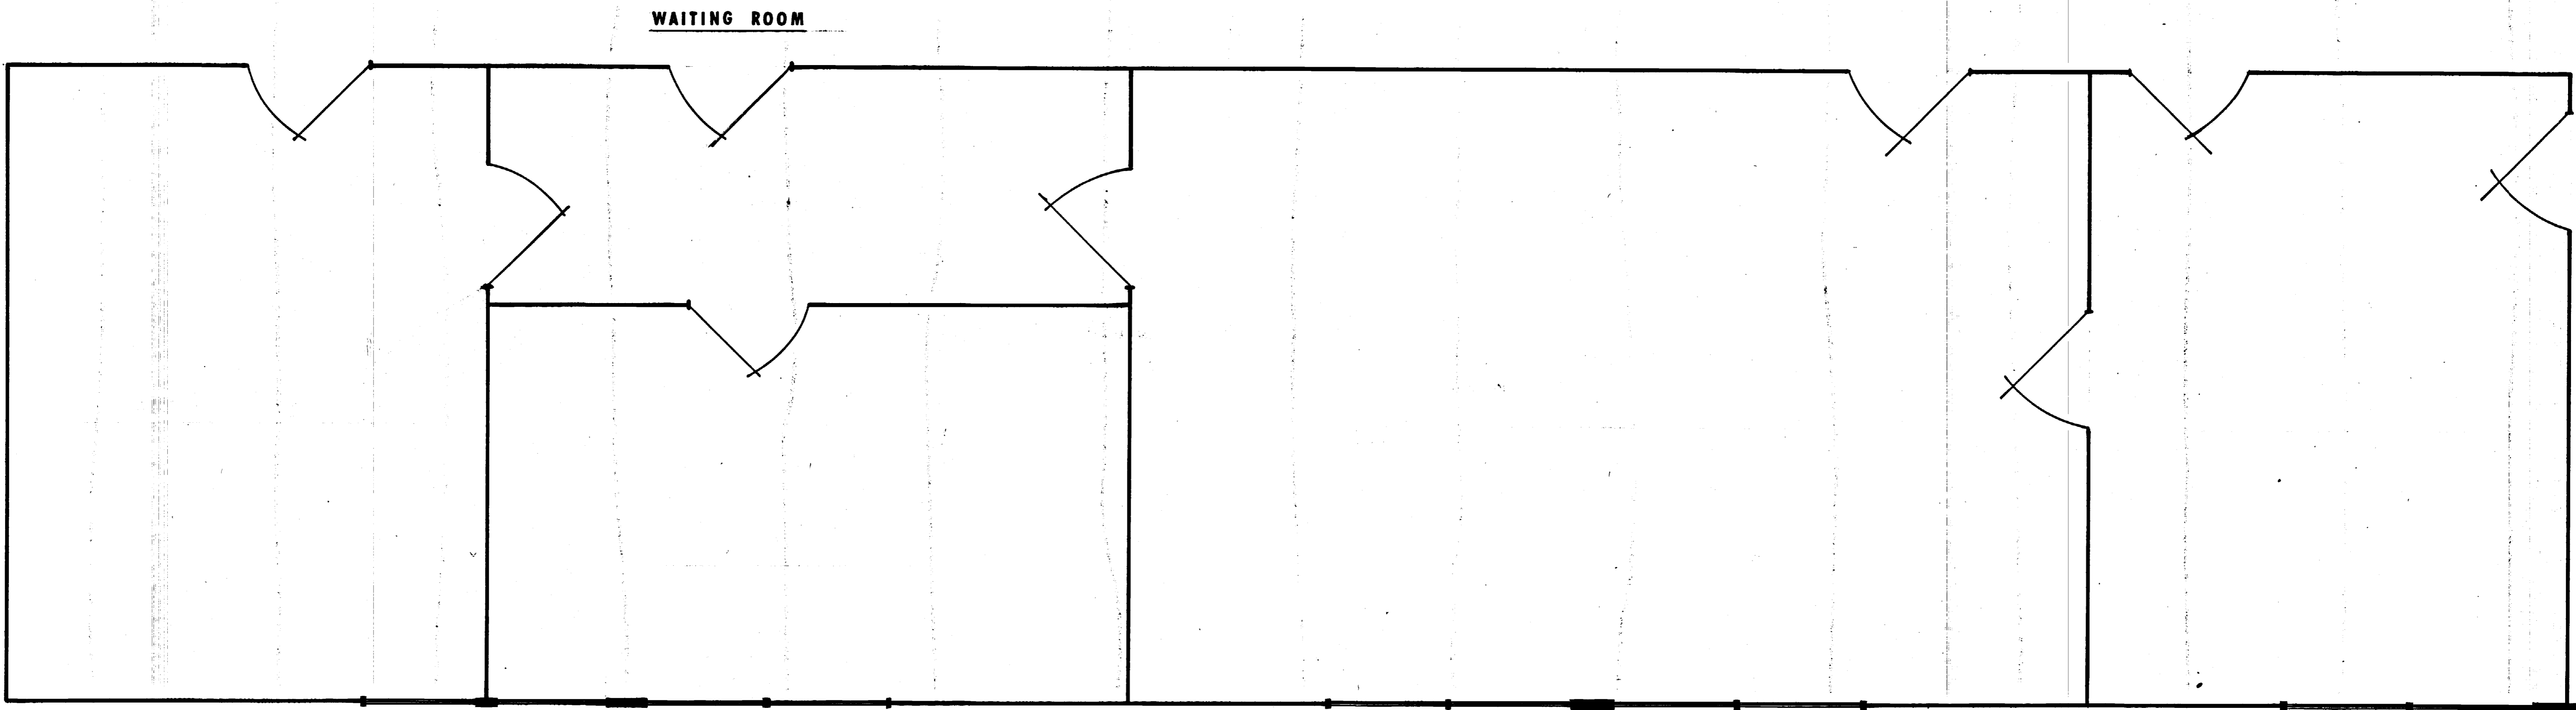

WAITING ROOM

CITY MANAGER

ASS'T. CITY MANAGER

SECRETARIAL


COUNCIL OFFICE

CITY HALL OFFICES

Scale: 1/2" = 1'-0"

51045

BUILDING INSPECTOR

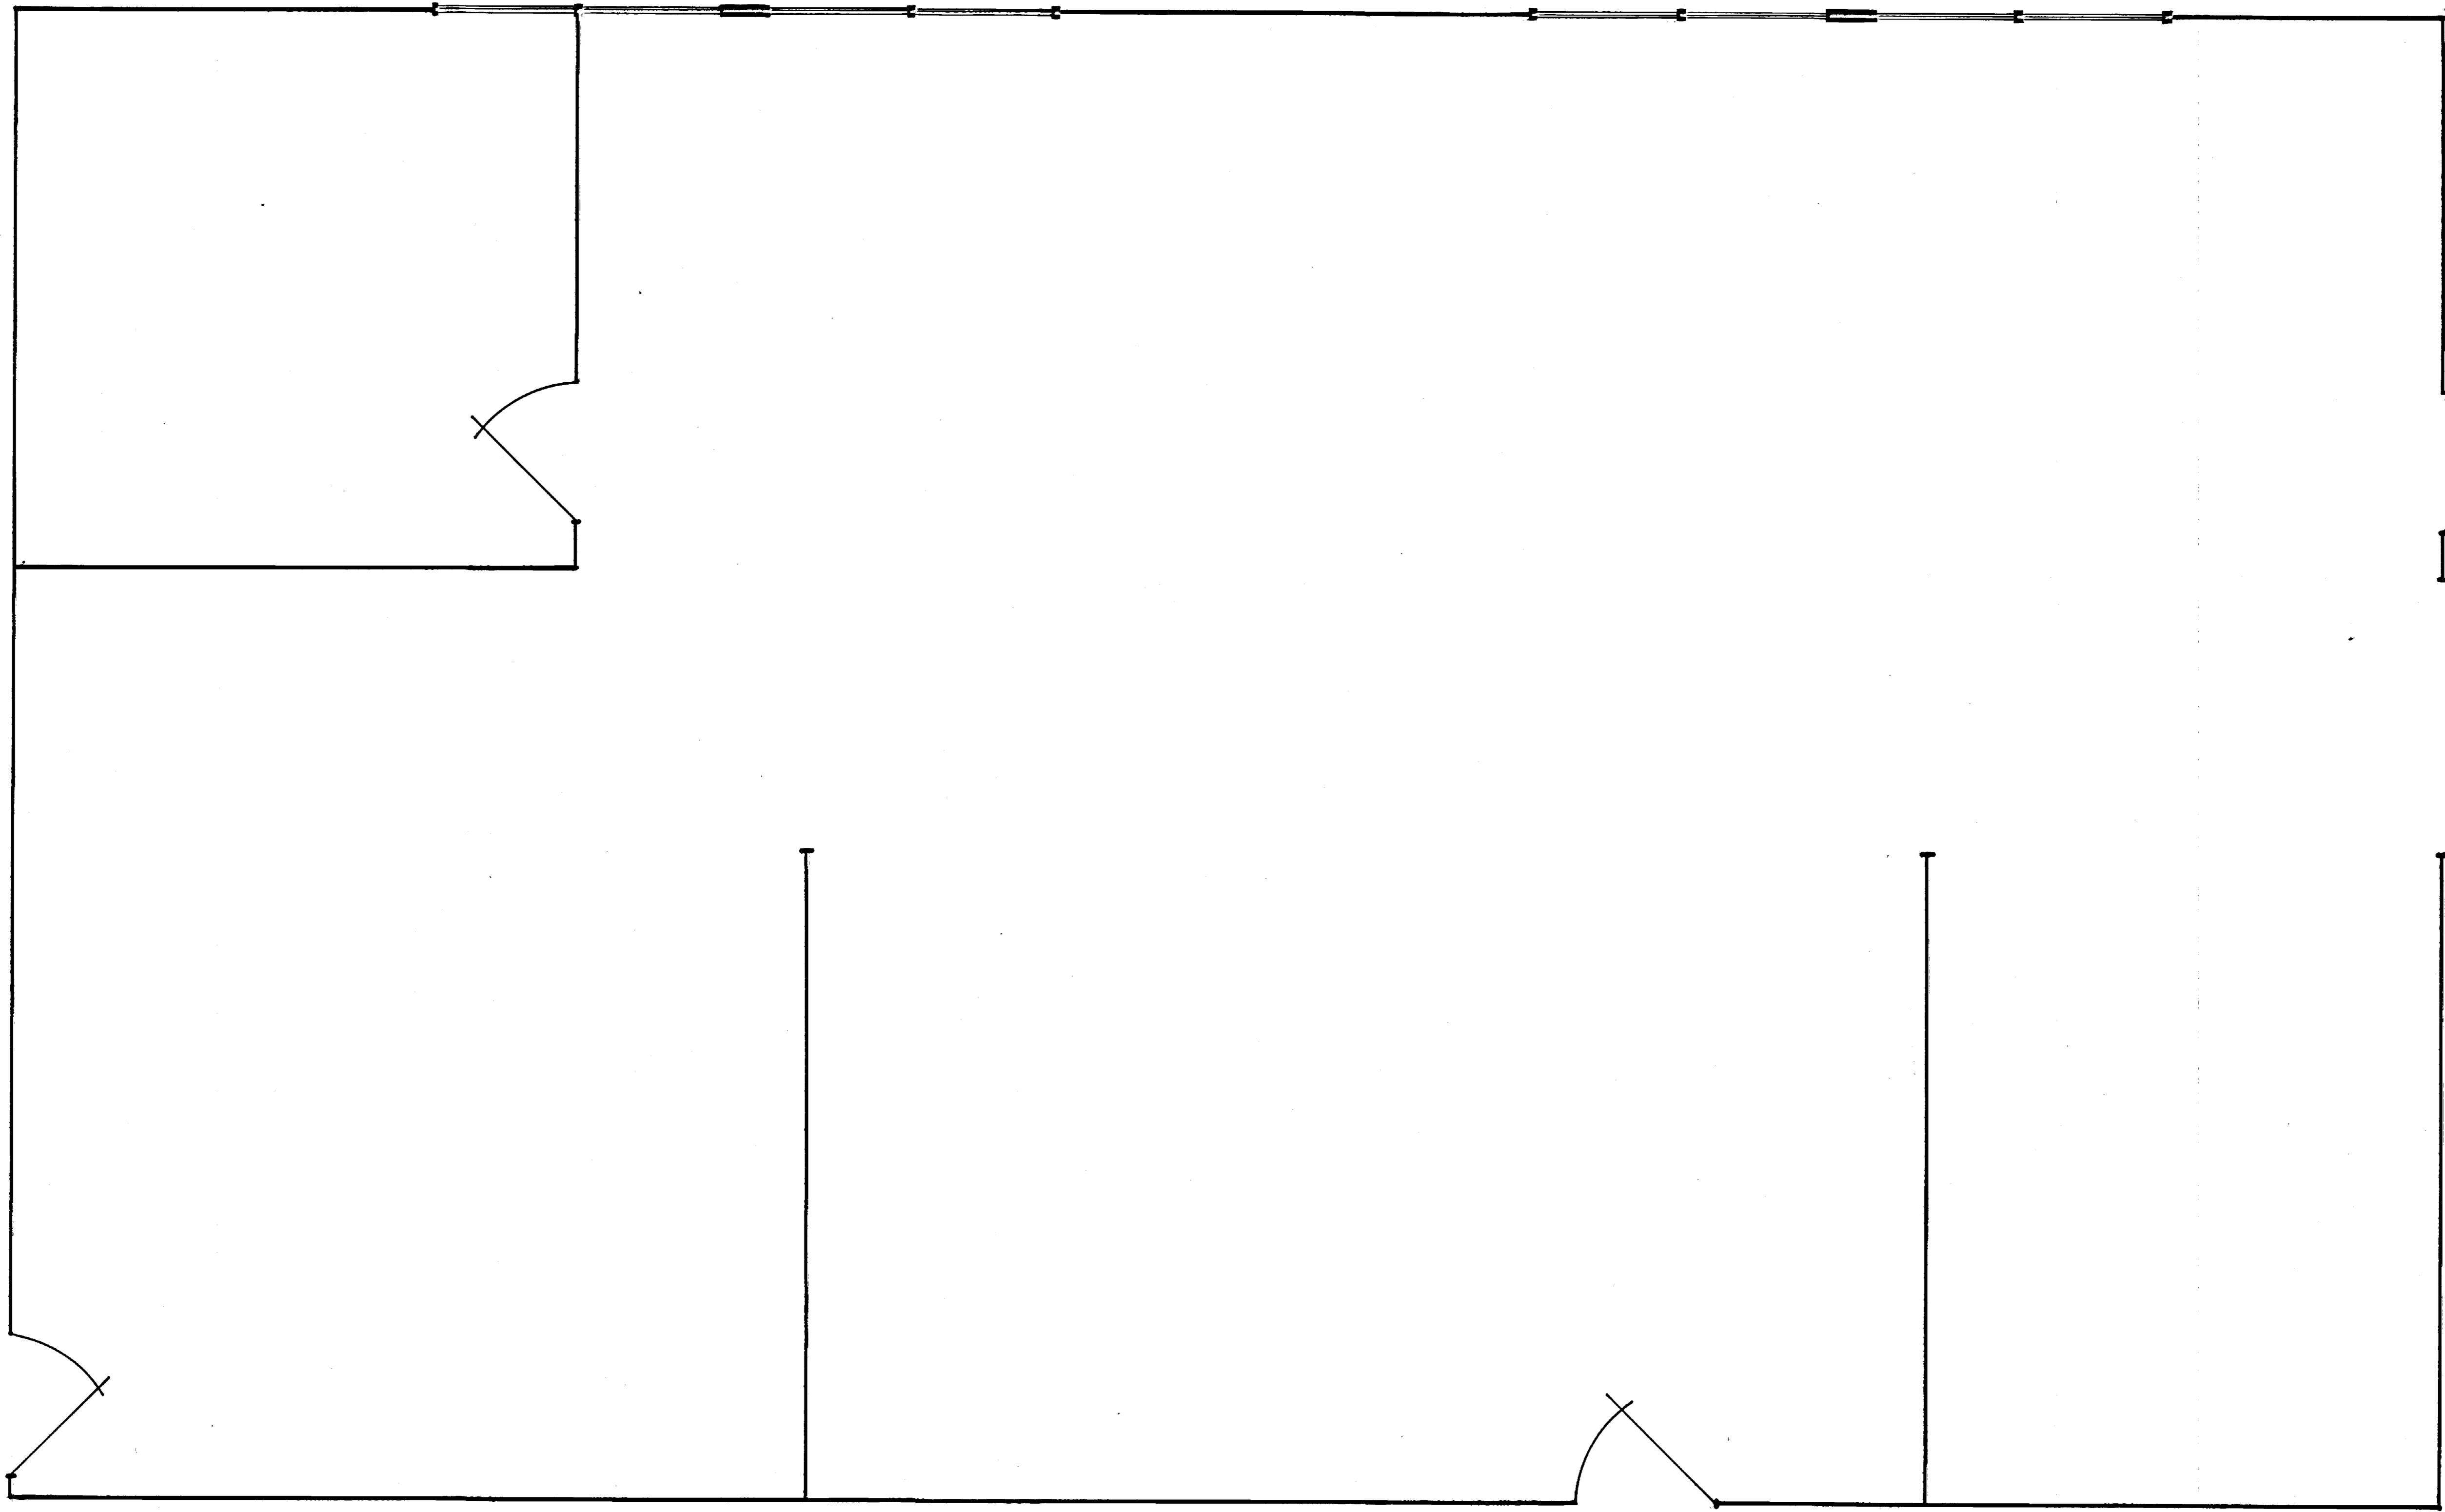


BUILDING DEPT. SECRETARY

BUILDING DEPARTMENT

CONFERENCE


CITY HALL OFFICES

Scale:  $\frac{1}{2}'' = 1'-0''$

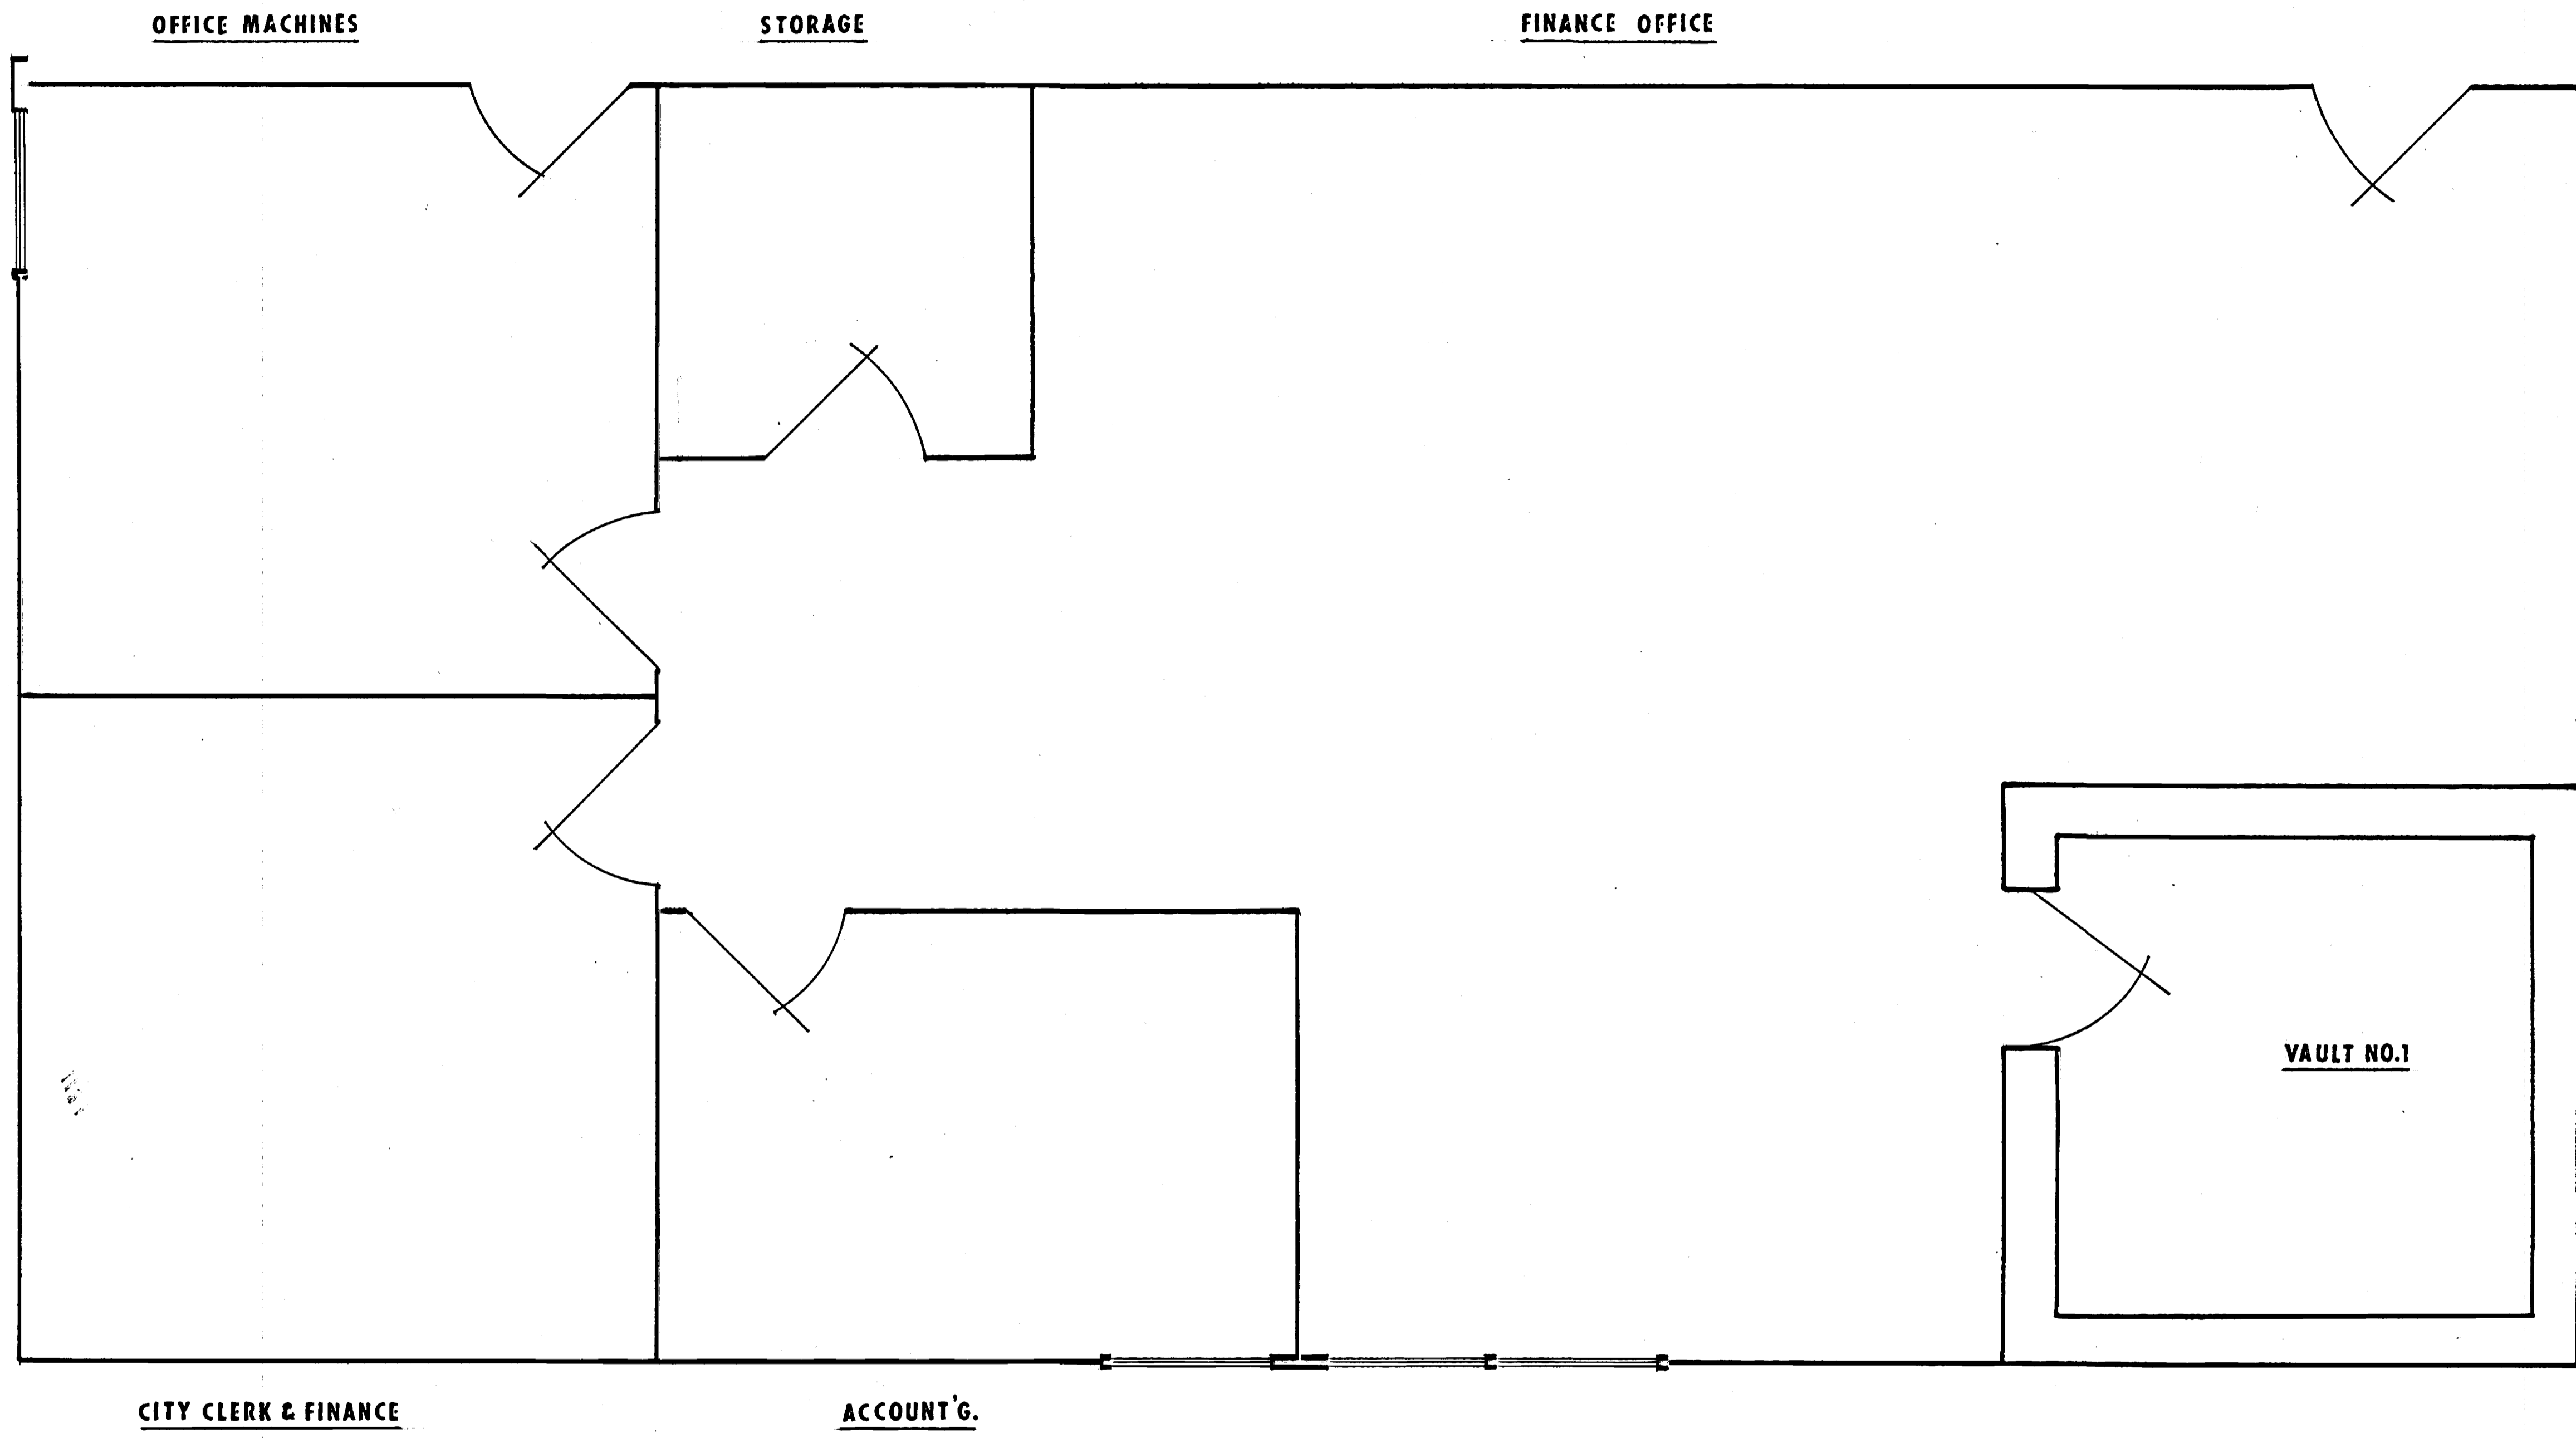



CITY HALL OFFICES  
Scale:  $\frac{1}{2}$ " = 1'-0"

51045 *F*

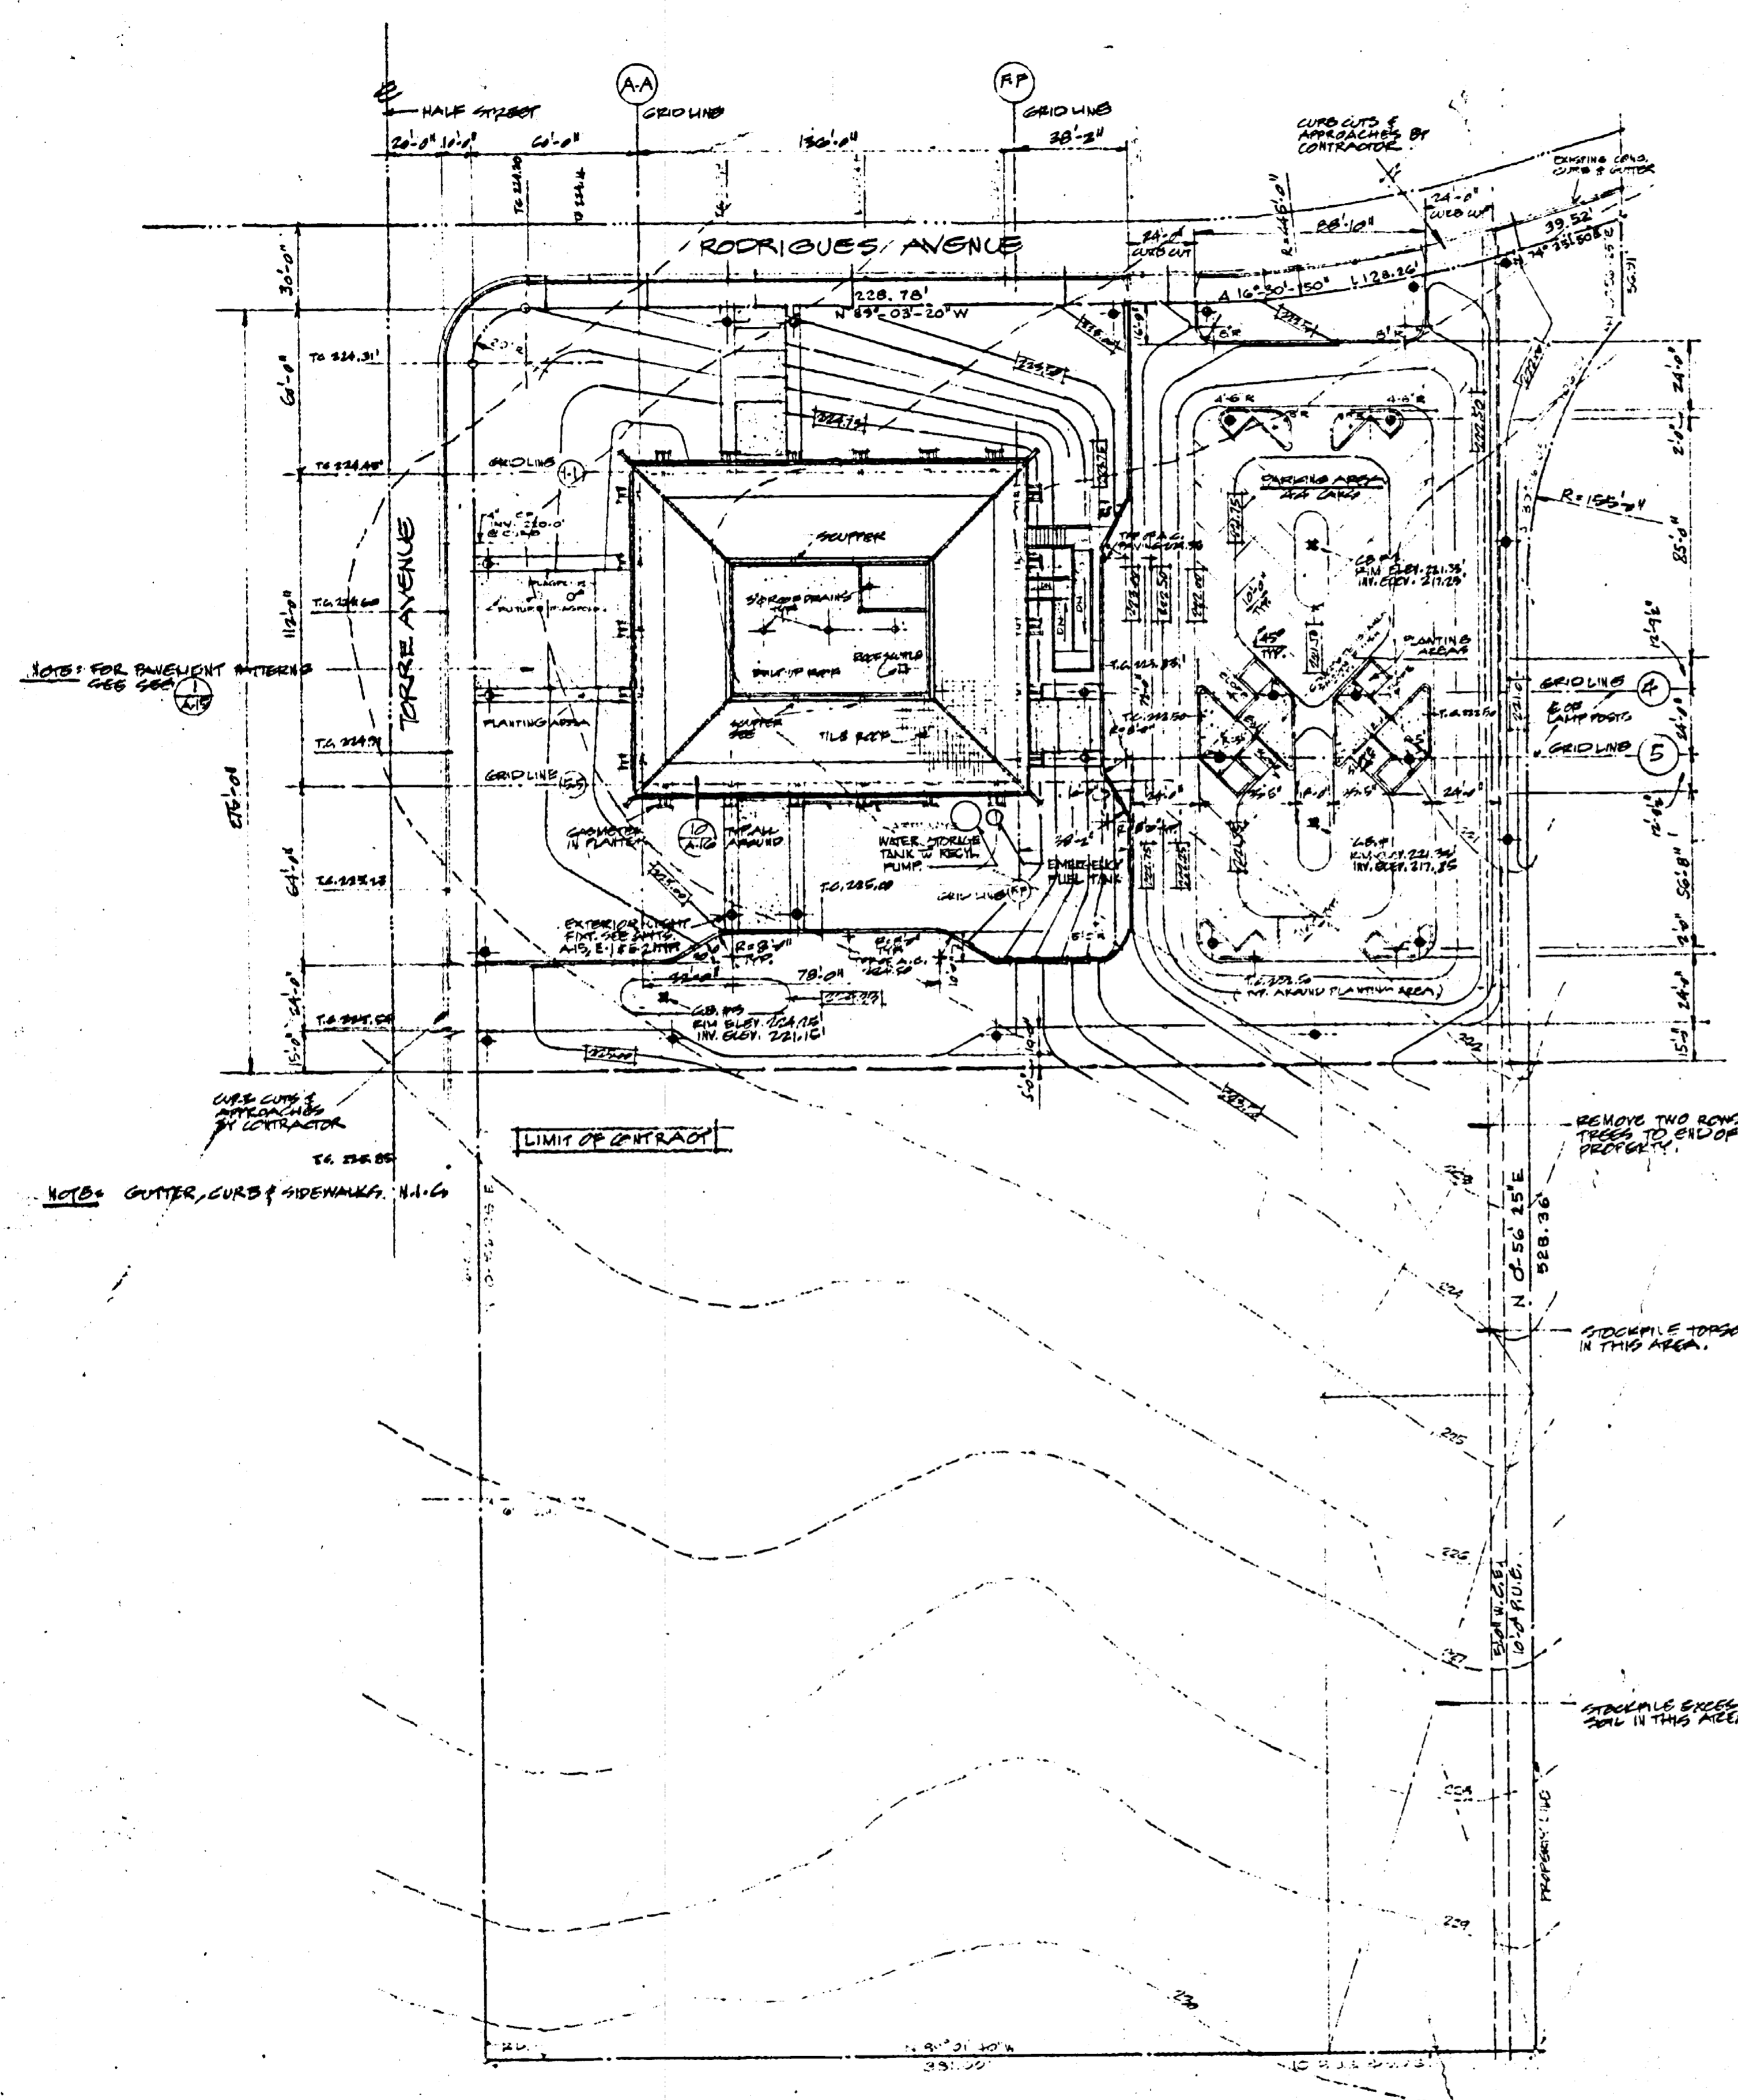

NOTE: TOP OF CONC. FLOOR FIN. SLEV. 227.20

SITE PLAN  
SCALE: 1" = 40'-0"

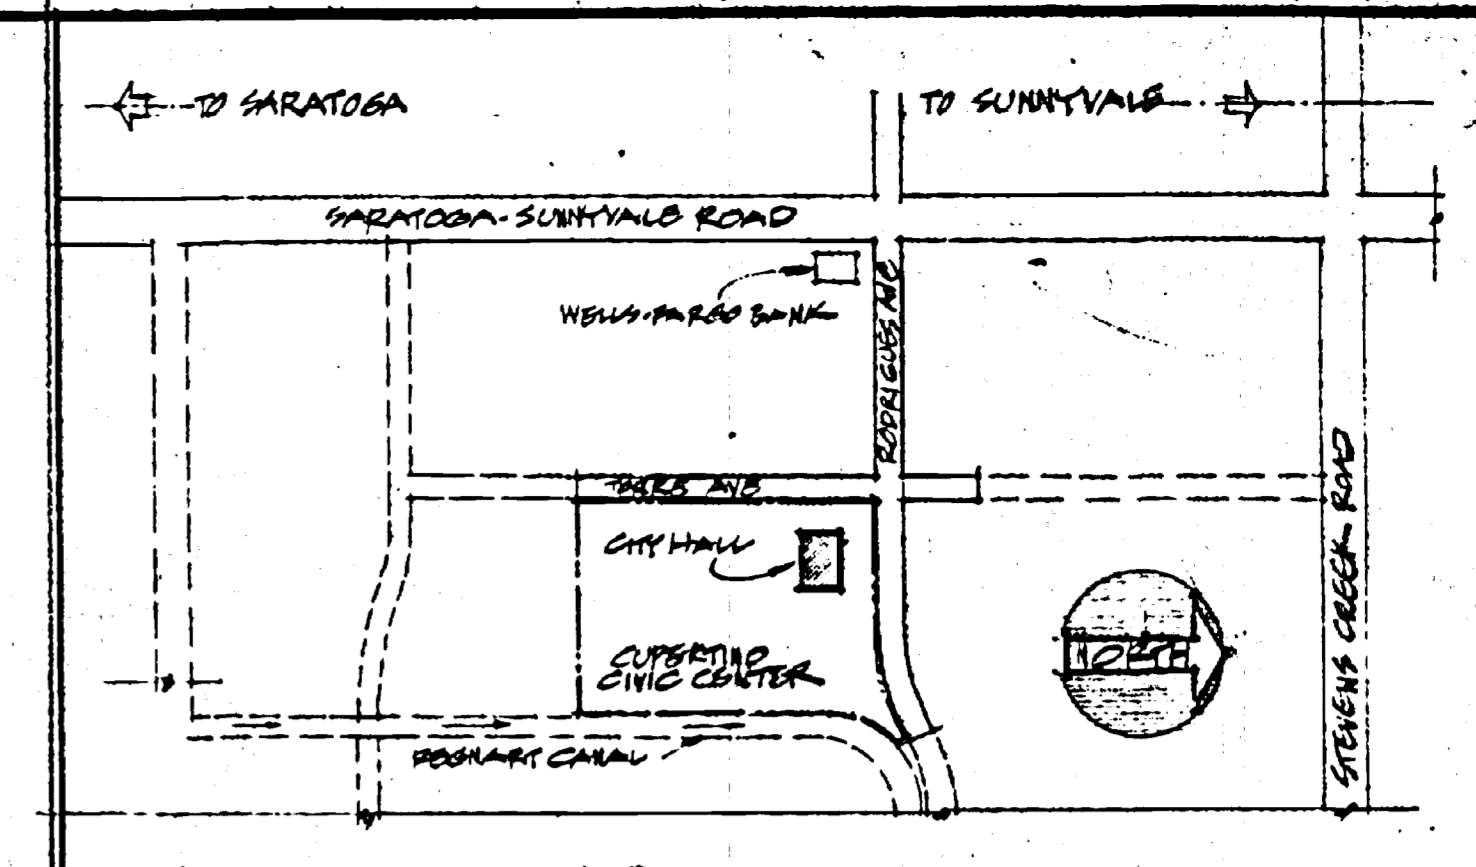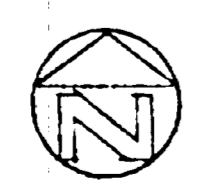

SITE LOCATION MAP  
NOT TO SCALE

SHEET INDEX

ARCHITECTURAL

A-1	SITE & GRADING PLAN, LOCATION MAP, ABBREVIATIONS
A-2	BASMENT PLAN - GENERAL USAGE
A-3	BASMENT PLAN - MECHANICAL
A-4	SECTION PLANS
A-5	MECHANICAL - BASMENT PLAN
A-6	SECTION PLANS
A-7	SECTION PLANS - WALLS & CEILING
A-8	SECTION PLANS - ROOFING, EXTERIOR WALLS, INTERIOR WALLS
A-9	SECTION PLANS - DOORS & WINDOW INTERIOR DETAILS
A-10	SECTION PLANS - EXTERIOR WALLS
A-11	INTERIOR WALL SYSTEMS
A-12	EXTERIOR WALLS
A-13	SECTION PLANS - ROOFING & CEILING DETAILS
A-14	SECTION PLANS - ROOFING & CEILING DETAILS
A-15	SECTION PLANS
A-16	SECTION PLANS - EXTERIOR WALLS

DRAWN BY: [ ]  
CHECKED: [ ]  
DATE: [ ]  
REVISED: [ ]


WILFRED E. BLESSING A.I.A.  
ARCHITECT & LANDSCAPE ARCHITECT

1995 THE ALAMEDA  
SAN JOSE, CALIFORNIA 95131


CUPERTINO CITY HALL  
S.E. CORNER OF RODRIGUES & TORRE, CUPERTINO, CALIFORNIA

SITE PLAN

[Signature]

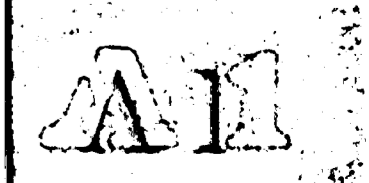

151,045

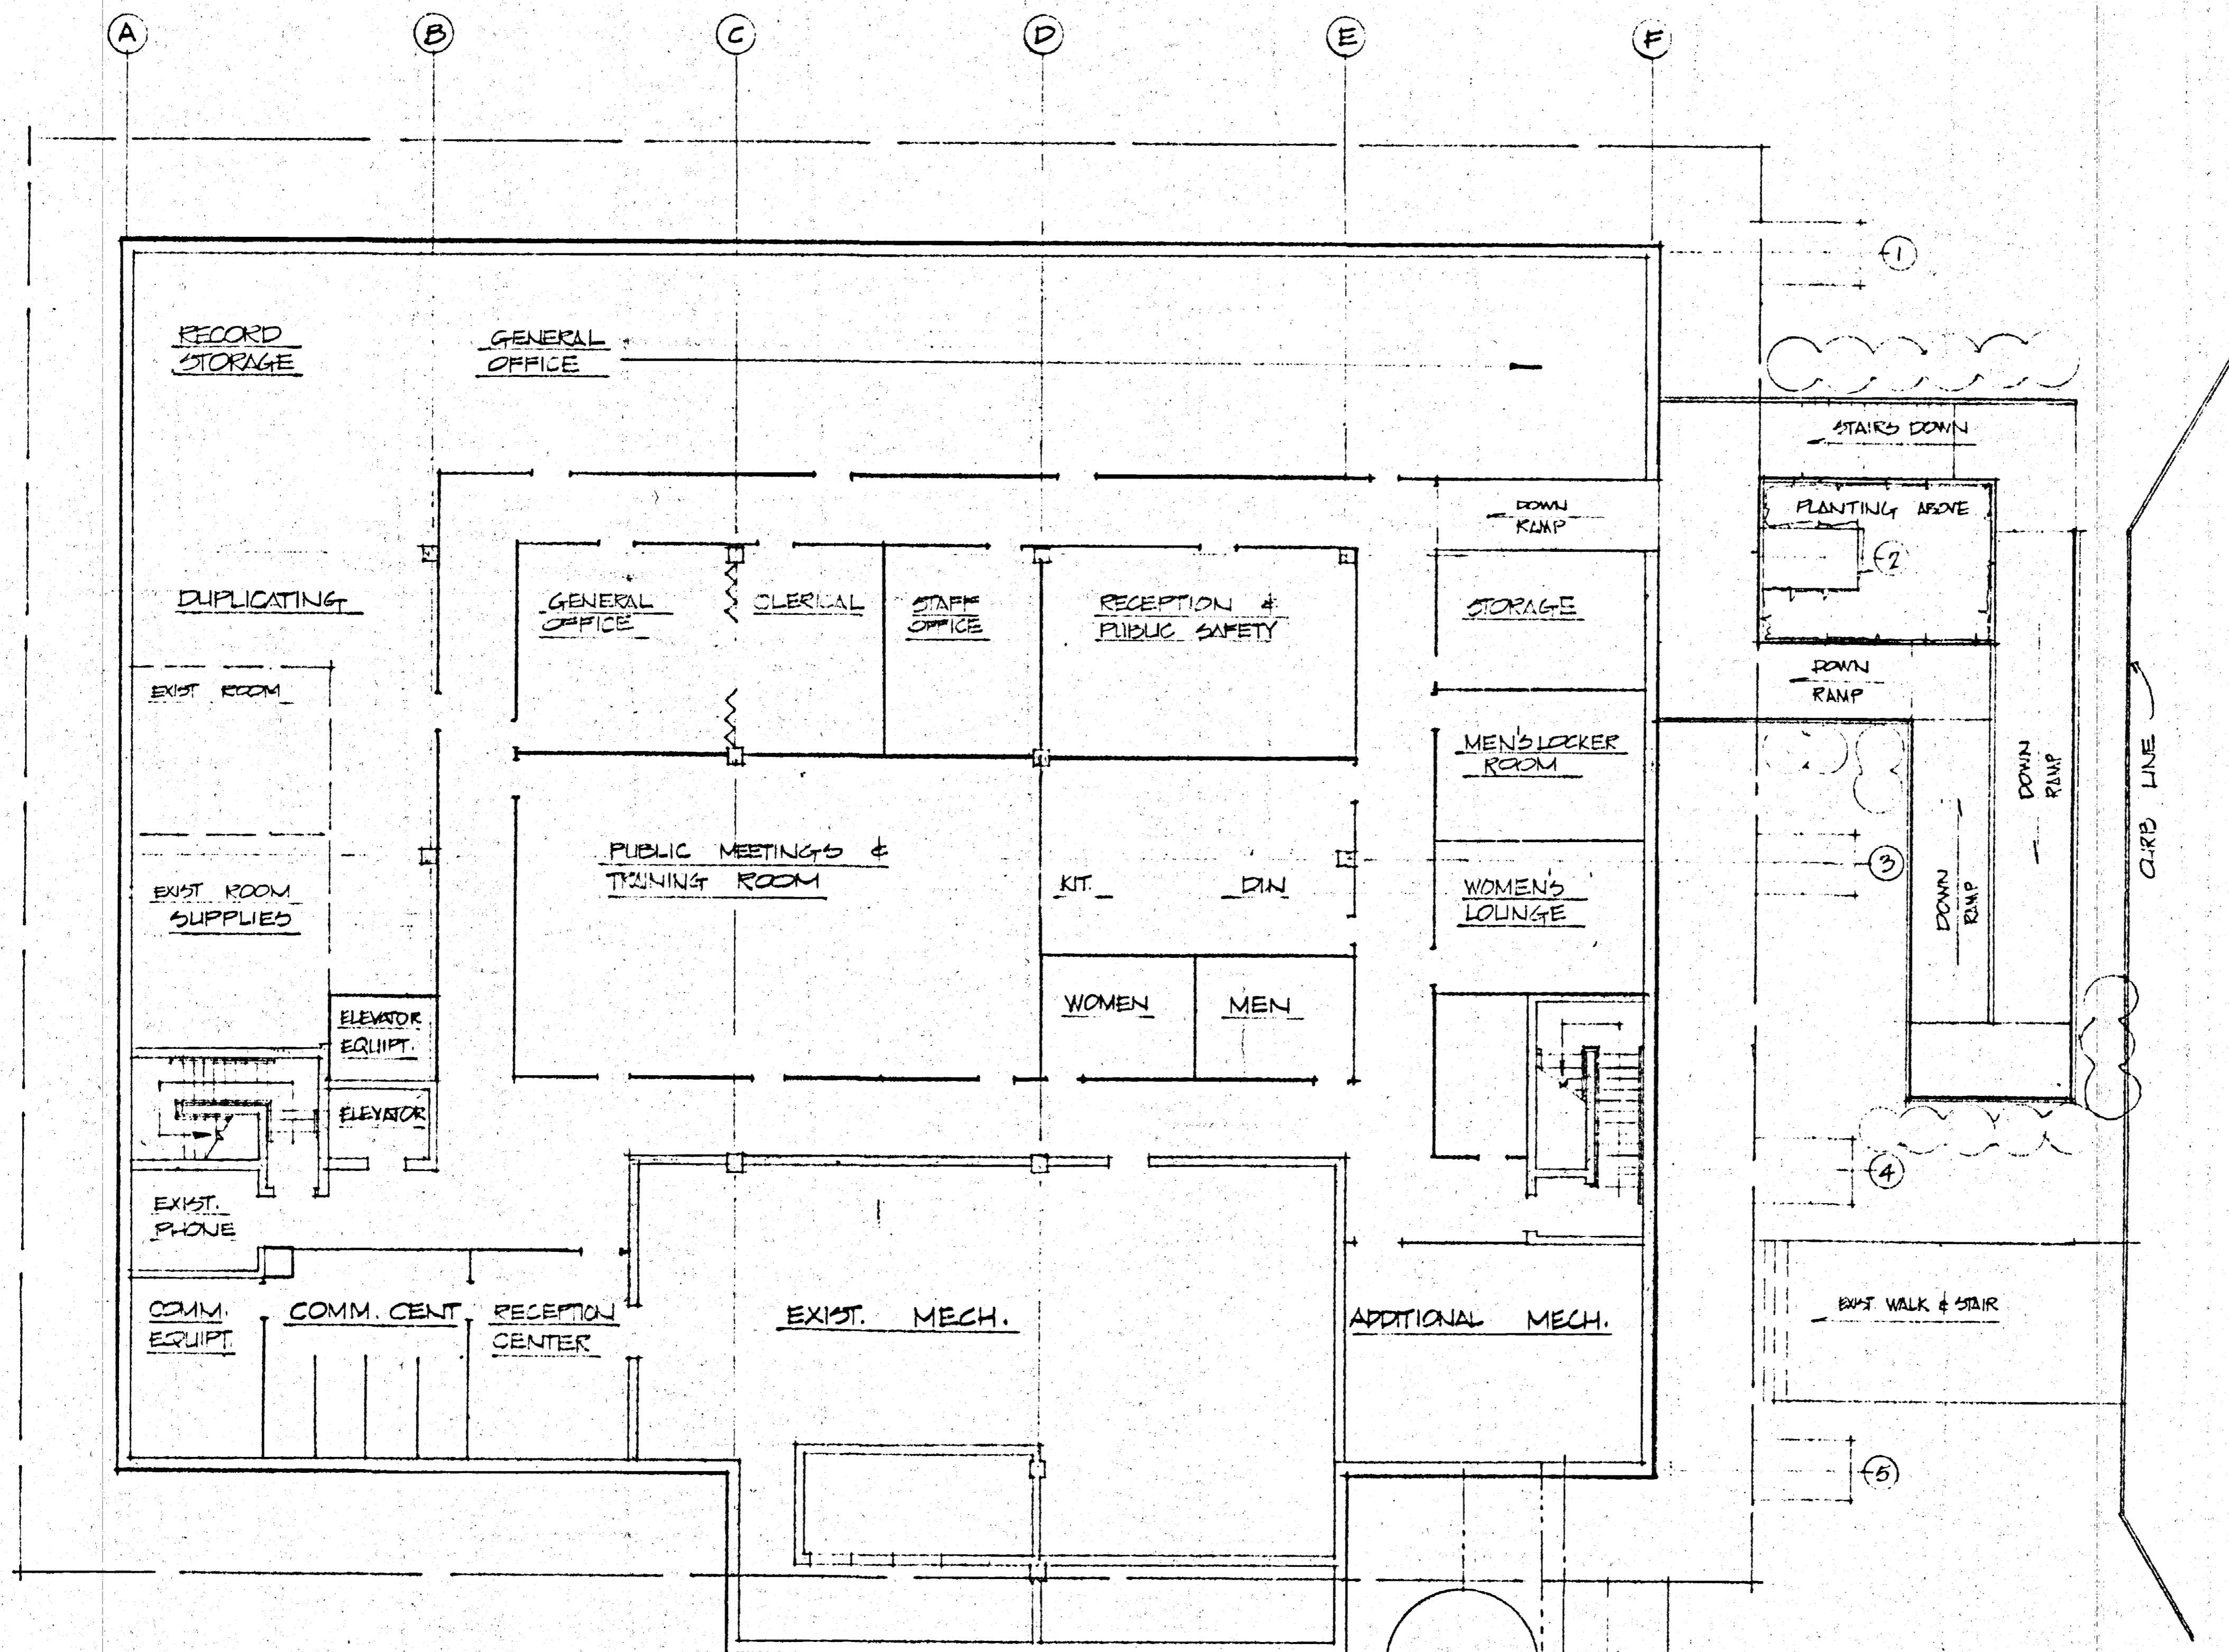


BASEMENT PLAN

5000 GAL. WATER STORAGE TANK w/ RECY. PUMP  
SEWAGE HOLDING TANK (IF POSSIBLE)  
EMERGENCY FUEL STORAGE TANK + 5000 GAL. TANK

SCALE 1/8" = 1'-0"

WILFRED E. BLESSING F.A.I.A. ARCHITECT & LANDSCAPE ARCHITECT SAN JOSE, CALIFORNIA	WILFRED E. BLESSING ARCHITECTS	DATE	REVISION
CUPERTINO CITY HALL		BASEMENT PLAN - GENERAL USAGE	
A-2		51,045	



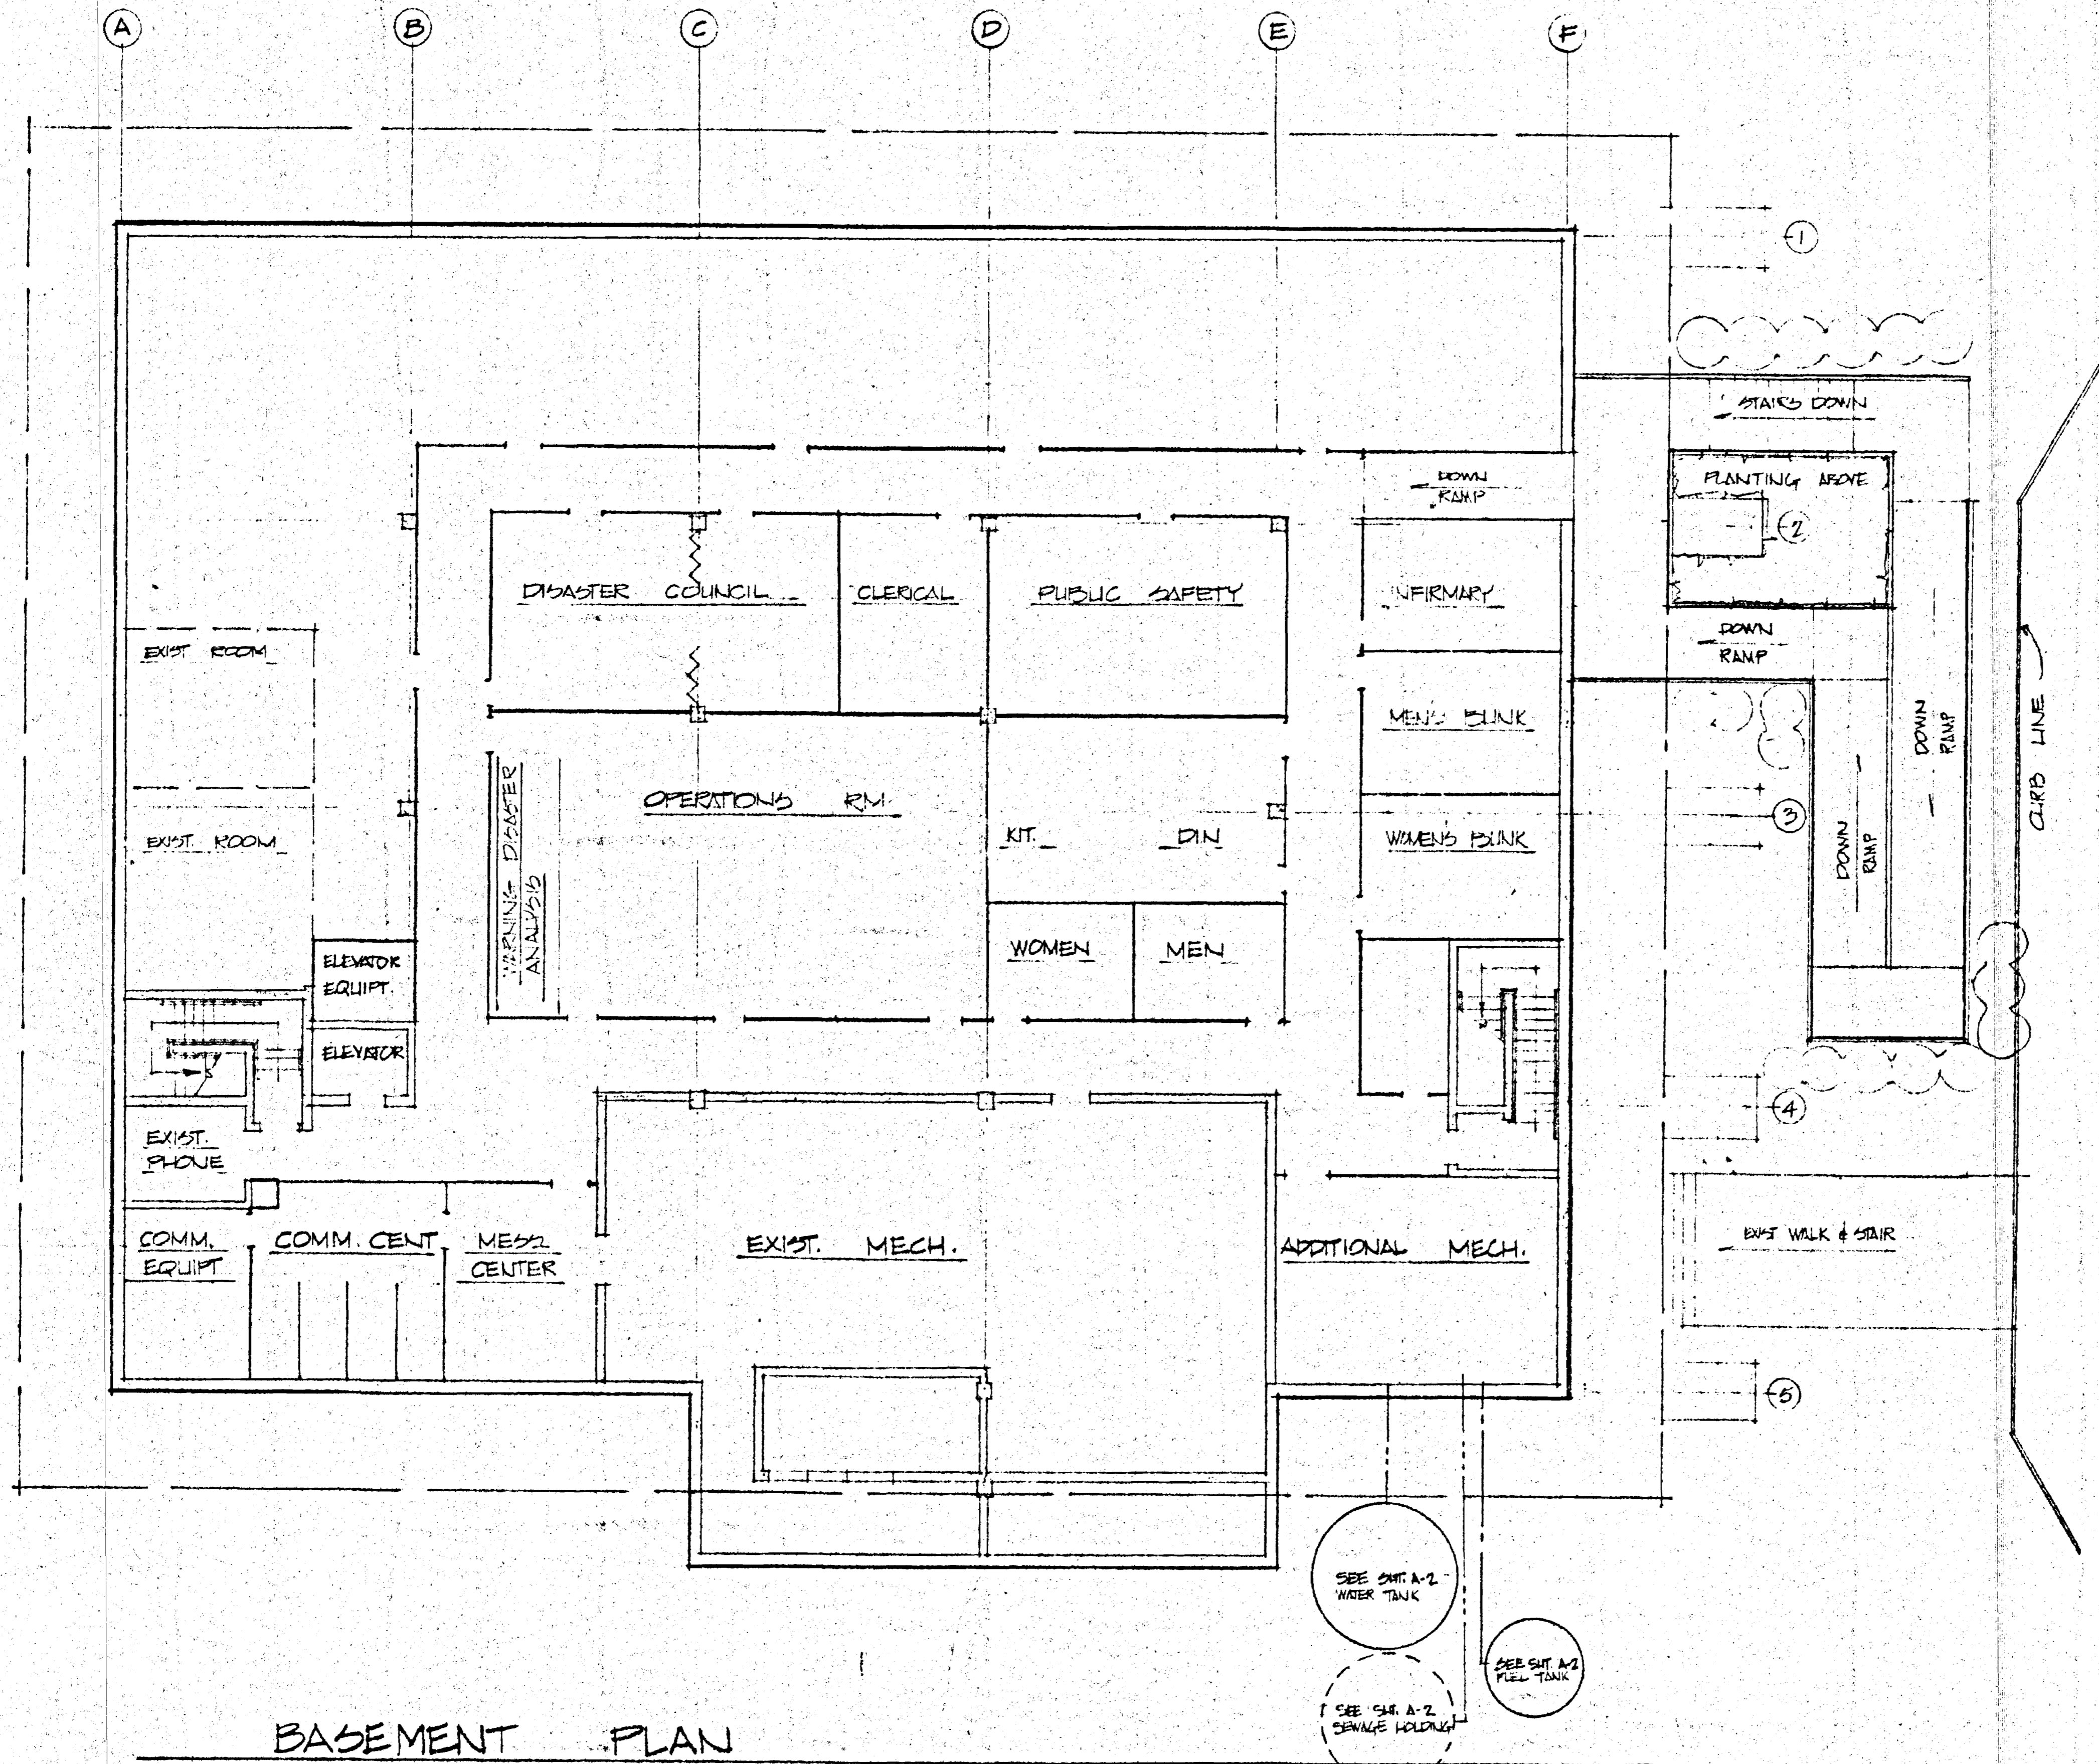

BASEMENT PLAN

SCALE 1/8" = 1'-0"

DRAWN W.F.  
CHECKED  
DATE 1-18-75  
3-5-75  
REVISIONS

WILFRED E. BLESSING F.A.I.A.  
ARCHITECT & LANDSCAPE ARCHITECT  
SAN JOSE, CALIFORNIA

CUPERTINO CITY HALL  
BASEMENT PLAN - E.O.C. PLAN

A:3

51,045